MONUMENT RECORD LAND SURVEY PUBLIC

Note: This form is intended and designed to fulfill all requirements of Wisconsin Administrative Code, Chapter A-E 7.08 U.S. Public Land Survey Monument Record (3)(a)(b)(c)(d)(e)(f)(g)(h)(i). An additional sheet may be added if necessary to conform with said requirements.

(a) CORNER LOCATION: Cor. of Secs. 4, 5, 32 & 33 Township 36 & 37 North Range 4 East of the 4th P.M. Town of Lynne

Oneida County Coordinates N: 167,430.161 USft

E: 112,888.245 USft Datum: NAD 1983(1991)

County of Oneida

SEC 32

(b) HISTORY OF ORIGINAL CORNER ESTABLISHMENT

Original Surveyor: Alexander Anderson

Date of Survey: Commenced: July 13, 1864

Completed: July 24, 1864

Original Accessories:

hemlock 10" S38°W, 29 lks. hemlock 8" N78°E, 31 lks. sugar 7" N17°W, 23 lks. hemlock 8" S58°E, 40 lks.


(b) (f) (g) (h) Description of monument found at this corner and if it was accepted, state all evidence (material, testimonial, occupational, plats, records, other monuments) used as a basis for accepting. If not accepted or if nothing was found, state evidence used as basis for establishing location. If re-established through lost corner proportionate methods, indicate all monuments, distances and directions used to establish. Indicate type of monument and sign post found or set.

February 14, 1939: Notes by Gobler in Book 97 on Pages 18 & 22 indicate he was running a random line West past this point with no mention of finding the original corner.

October 2, 2012: An extensive search for evidence of the General Land Office survey and any subsequent resurveys mentioned above was performed. Having found none, the corner was positioned by proportionate measure as shown on map number C-2776 filed in the office of the Oneida County Surveyor. The GLO topographic calls were also evaluated to confirm the validity of the position. At the corner point a 2-1/2" diam., 30" long aluminum pipe with 3-1/4" diam. Oneida County aluminum cap projecting 13" above the ground surface was set. The monument is somewhat unstable, but this is as deep as it could be set due to an unknown obstruction. Accessories were established as above helps and a white plastic sign past bears South 1 ft dist shown below and a white plastic sign post bears South, 1 ft. dist.

The coordinates shown were derived from two independent RTK observations of the corner point and are based on the WISCORS network.

(c)(d)(e) Plan view of corner with ties to at least 4 witness monuments. If in disagreement with previously established corner, show the distances between the two corners and also indicate the ties to the disputed.

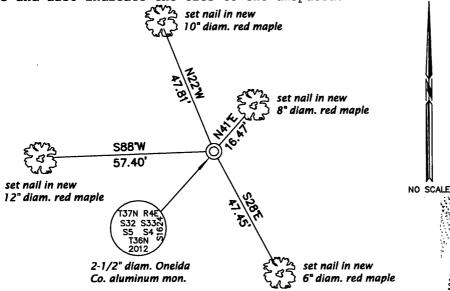

(i) I, Michael J. Romportl, Registered Land Surveyor No. S-1624, hereby certify that the corner location on this record was determined by me or under my direction and control and that this U.S. Public Land Survey Monument Record is correct and complete to the best of my knowledge and belief.

Romports 2/18/2013 Signature

REGISTER OF DEEDS OFFICE ONEIDA COUNTY **FILED** APR 152013 O'CLOCK KYLE J. FRANSON REGISTER OF DEEDS

MICHAEL J.
ROMPORTL
S. 1624
RHINELANDER,
WI

SURVEYOR SURVEYOR

3704320000 (INDEX NO. Z-9)