


U.S. PUBLIC LAND SURVEY MONUMENT RECORD

Note: This form is intended and designed to fulfill all requirements of Wisconsin Administrative Code, Chapter A-E 7.08 U.S. Public Land Survey Monument Record (3) (a) (b) (c) (d) (e) (f) (g) (h) (i). An additional sheet may be added if necessary to conform with said requirements.

(a) Corner location: Township 36 North
 Range 4 East/West

Town/City/Village Lynne
 County Oneida

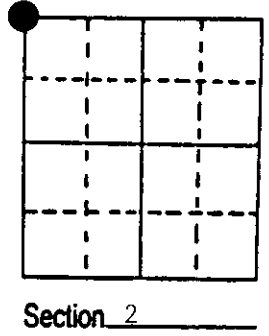


(b) (f) (g) (h) Description of monument found at this corner and if it was accepted, state all evidence (material, testimonial, occupational, plats, records, other monuments) used as a basis for accepting. If not accepted or if nothing was found, state evidence used as basis for establishing location. If reestablished through lost corner proportionate methods, indicate all monuments, distances and directions used to establish. Indicate type of monument found or set and sign post.

- 1860 - James McBride established corner and set a wood post with BTs:
 - 6" Cedar, N70°E, 40 Links
 - 7" Spruce, S35°W, 35 Links
 - 10" Tamarack, S50°E, 13 Links
 - 6" Spruce, N40°W, 15 Links
- 1940's - A. J. Lytle re-established this corner from original BTs and set a 2" x 60" iron pipe with brass pipe cap, stamped to identify it, with two BTs:
 - Spruce, N16°E, 26.5 Feet
 - Spruce, N54°W, 2.6 Feet
- 4/3/1989 - Romportl and crew found corner and placed plastic target.
- 3/14/1991 - Milo E. Stefan found monument tipped and both Lytle BTs now snags. Original Tamarack BT a decayed stump, four new BTs made by unknown party. We took measurements and bearings and set new sign post - after monument was placed vertical.

(c) (d) (e) Plan view of corner with ties to at least 4 witness monuments. If in disagreement with previously established corner, show the distances between the two corners and also indicate the ties to the disputed corner.

- 1) 2" x 60" iron pipe/brass pipe cap
- *2) 6" Black Spruce, N50°E, 20.40 feet
- *3) 8" Tamarack, S45°E, 23.70 feet
- *4) 6" Black Spruce, S50°W, 27.89 feet
- *5) 6" Black Spruce, N46°W, 32.46 feet
- 6) Original Tamarack BT, S50°E, 13 Links (8.58')
- 7) Spruce snag, N16°E, 26.5 feet
- 8) Plastic sign post, N54°W, 2.6 feet
- 9) Plastic sign post, West, .3 feet

Distances to nail in side of BTs
 *BTs scribed in stump blaze

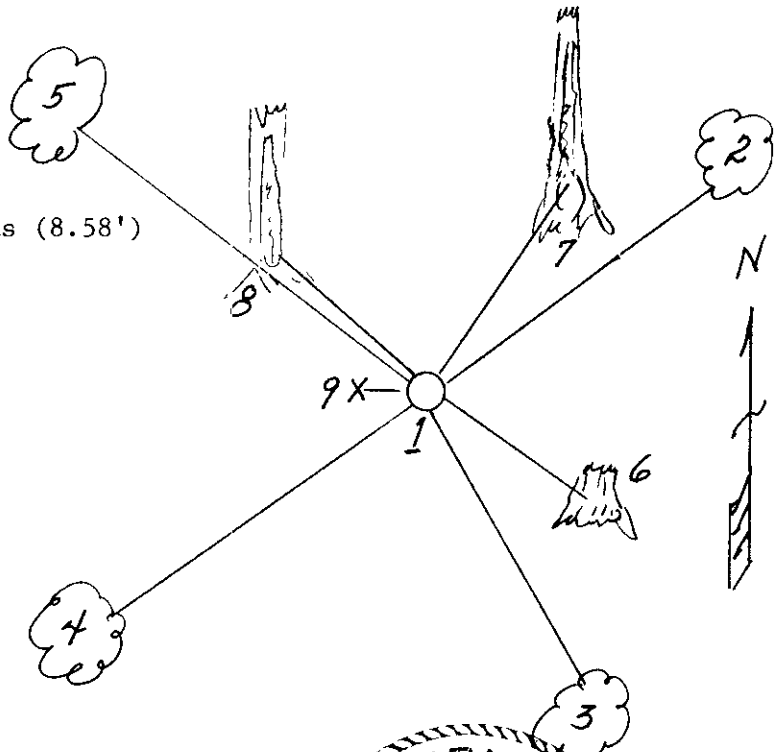

REGISTER OF DEEDS OFFICE
 ONEIDA COUNTY, WIS.

FILED

APR 8 1991

At _____ O'Clock _____ M
THOMAS H. LEIGHTON
 REGISTER OF DEEDS

WISCONSIN
 MILO E. STEFAN
 1958
 LAND SURVEYOR

(i) I, Milo E. Stefan
 (type or print name) certify that the corner location on this record was determined by me or under my direction and control and that this U.S. Public Land Survey Monument Record is correct and complete to the best of my knowledge and belief.

Milo E. Stefan March 16, 1991
 Signature Date

Stamp
 3704340000

Index No. A-17