

U.S. PUBLIC LAND SURVEY MONUMENT RECORD


Note: This form is intended and designed to fulfill all requirements of Wisconsin Administrative Code, Chapter A-E 7.08 U.S. Public Land Survey Monument Record (3) (a) (b) (c) (d) (e) (f) (g) (h) (i). An additional sheet may be added if necessary to conform with said requirements.

(a) Corner location: Township 36 North

Range 4 East/West

Town/City/Village Lynne


County Oneida

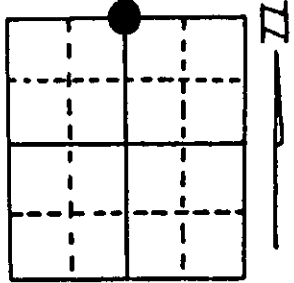

Section 3

(b) (f) (g) (h) Description of monument found at this corner and if it was accepted, state all evidence (material, testimonial, occupational, plats, records, other monuments) used as a basis for accepting. If not accepted or if nothing was found, state evidence used as basis for establishing location. If reestablished through lost corner proportionate methods, indicate all monuments, distances and directions used to establish. Indicate type of monument found or set and sign post.


- 1860 - James McBride established this corner at 40.00 chains and set a post with two BTs: 10" Birch, N23°E, 22 Links (14.52') 14" Birch, S36°W, 11 Links (7.26')
- 11/5/1934 - A. J. Lytle restored corner by Lost Methods. He found distances between Section Corners to be 79.60 chains (5253.60'). He called a wood post.
- 3/29/1995 - Milo E. Stefan ran traverse from A-17 West to locate this corner and/or A-13. After finding and positioning A-13, we restored this corner by Lost Methods. No evidence of Lytle's work was located.

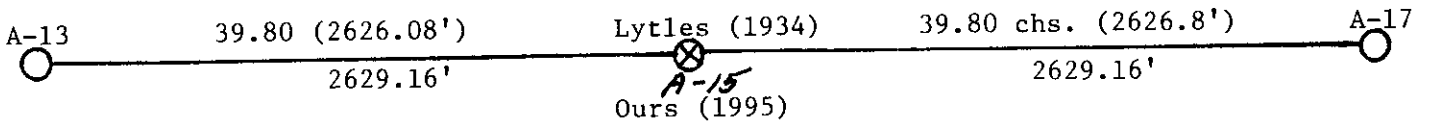


(c) (d) (e) Plan view of corner with ties to at least 4 witness monuments. If in disagreement with previously established corner, show the distances between the two corners and also indicate the ties to the disputed corner.

- 1) 2" x 30" Aluminum Monument.
- 2) 5' x 5' x 18" High Granite Boulder, North, 15.60' (+ on high point).
- 3) 6" Black Ash, N40°E, 52.01'.
- 4) 7" Black Ash, S84°E, 68.73'.
- 5) 10" Tamarack, S78°W, 103.53'.
- 6) Plastic Sign Post, Northwest, .55'.

Distances to nail in side of BTs.
Stump blaze scribed "BT".
BT tag on face of each BT.

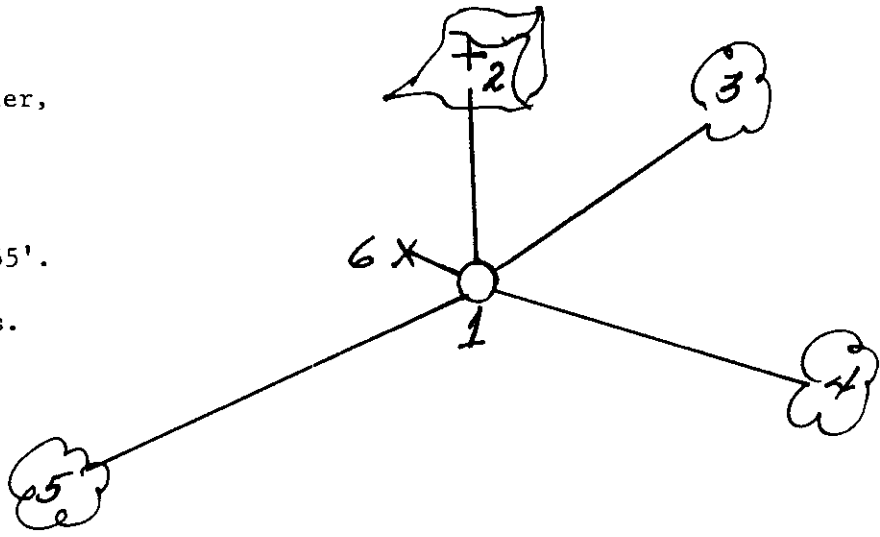

REGISTER OF DEEDS OFFICE
ONEIDA COUNTY, WIS

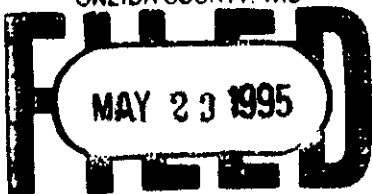

At _____ O'Clock _____ M
THOMAS H. LEIGHTON
REGISTER OF DEEDS

(i) I, Milo E. Stefan
(type or print name) certify that the corner location on this record was determined by me or under my direction and control and that this U.S. Public Land Survey Monument Record is correct and complete to the best of my knowledge and belief.

Milo E. Stefan
Signature

May 11, 1995
Date



Index No. A-15