


U.S. PUBLIC LAND SURVEY MONUMENT RECORD

Note: This form is intended and designed to fulfill all requirements of Wisconsin Administrative Code, Chapter A-E 7.08 U.S. Public Land Survey Monument Record (3) (a) (b) (c) (d) (e) (f) (g) (h) (i). An additional sheet may be added if necessary to conform with said requirements.

(a) Corner location: Township 36 North
 Range 4 East/West

Town/City/Village Lynne

County Oneida

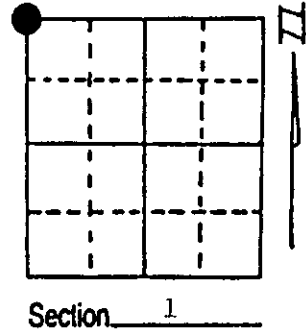

(b) (f) (g) (h) Description of monument found at this corner and if it was accepted, state all evidence (material, testimonial, occupational, plats, records, other monuments) used as a basis for accepting. If not accepted or if nothing was found, state evidence used as basis for establishing location. If reestablished through lost corner proportionate methods, indicate all monuments, distances and directions used to establish. Indicate type of monument found or set and sign post.

7/1864 - James McBride established this corner at 80.00 chains and set a wood post with four BTs:
 8" Hemlock, N60°E, 21 Links (13.86') 14" Birch, S60°E, 10 Links (6.60')
 10" Hemlock, S50°W, 14 Links (9.24') 9" Birch, N20°W, 7 Links (4.62')

10/20/1896 - B.F. Dorr was here, ran South 48.22 chains to Quarter and East 39.29 chains to Quarter. Did not say what he found or did to corner.


9/18/1934 - A.J. Lytle found evidence of original corner; both Birch stumps and roots of both Hemlock. He made one new BT: 10" Hemlock, N74°W, 24 Links (15.84').

8/2/1994 - Milo E. Stefan ran traverse from East - found 2" x 60" iron pipe broken off at ground line; base in ground and original 14" Birch BT rotted to ground line. Other BTs are only stump holes.
 We replaced iron pipe with a new Aluminum Monument, four new BTs and a 3" Oak guard stake.

(c) (d) (e) Plan view of corner with ties to at least 4 witness monuments. If in disagreement with previously established corner, show the distances between the two corners and also indicate the ties to the disputed corner.

- 1) 2" x 36" Aluminum Monument.
- 2) 12" Sugar Maple, N65°E, 32.34'.
- 3) 10" Norway Spruce, S13°E, 64.40'.
- 4) 8" Sugar Maple, S48°W, 35.18'.
- 5) 8" Sugar Maple, N85°W, 50.02'.
- 6) 3" Oak Guard Post, .1' North.

Distances to nail in side of BTs.
 Stump blazes scribed "BT".

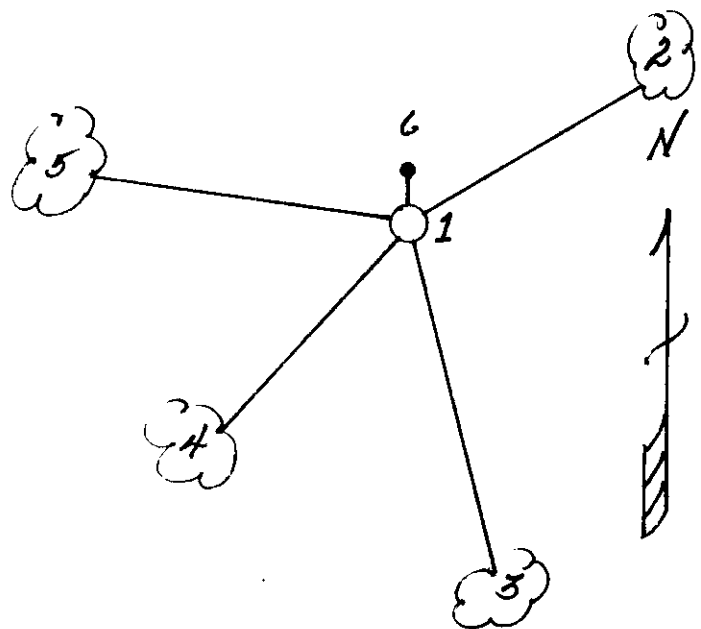

(i) I, Milo E. Stefan
 (type or print name) certify that the corner location on this record was determined by me or under my direction and control and that this U.S. Public Land Survey Monument Record is correct and complete to the best of my knowledge and belief.

Milo E. Stefan August 2, 1994
 Signature Date



Stamp 3704350000

Index No. A-21