

U.S. PUBLIC LAND SURVEY MONUMENT LOCATION RECORD

Recorders Data

CORNER: West 1/4 SECTION: 11 TOWNSHIP 37 NORTH RANGE 5 EAST/WEST

FOR M.C. CORNER INDICATE: NAME OF WATERWAY N/A SECTION LINE N/A


(CITY)(VILLAGE)(TOWN) OF: Little Rice COUNTY OF: Oneida

Description of monument found or placed and all other evidence used as a basis for monument location; including all monuments and related measurements required if the corner location is reestablished by lost corner proportionate methods. Also indicate name of original surveyor, survey date, corner monument set and established bearing trees, witness or reference monuments with ties from available records.

Found and accepted an old rusted 3/4" dia. iron pipe undisturbed with uncapped top 9" above existing grade at this corner location; also found upper 45" of an old wood 4" square corner marker post flat on grade westerly of monument. Corner falls in center of West slope from a higher ridge to the East, and about 300' West of an unimproved woods road which runs easterly and northerly to junction with Willow Dam Road at entrance driveway to Fire No. 5080. Corner location was shown to me by adjoining landowner James V. Quimette. I drove a standard 2" dia. by 30" long aluminum pipe monument with stamped Oneida County aluminum cap over the older iron pipe monument found with cap 6" above grade. In 1863, Jenkins/GLO set a wood post as the corner and marked BTs, an 8" Black Pine OBT N54°E 12 lks and an 8" Black Pine OBT N51°W 35 lks, which are all now obliterated; however, I did find an old rotting 8" pine tree that had fallen flat to NE, with root crown at N70°E about 8½ feet, with a plain box blaze on its upper face with a standard Owens-Illinois aluminum locator plate/tag nailed over it. In 1937, Maine notes a wood post at the corner during his retracement of the section line, which had also been ran by Vaughn in 1908, but noted no BTs. In 1967, a NEPCO survey notes a monument by others at the corner and BTs, an 8" Pj S08°E 15.0', which is now a fallen stub to NE with lower face blaze open with scribing above root crown, and a 7" Pj S86°W 18.0', which is now a 2½' high sawed 9" pine stump with lower face blaze open with scribing, which I painted Fl. orange and nailed a standard Oneida County Do Not Disturb sign to top of stump. In 1974, Plat of Survey by Margitan, filed as B-797, also used this corner location per recent query.

Plan view map of monument location with bearing and distance ties to a minimum of four(4) described witness or reference monuments of concrete, natural stone, iron, live bearing trees or equivalent material. If applicable, also show a minimum of two(2) bearing and distance ties to any other monument found and not accepted; including the bearing and distance from the accepted monument. Indicate the basis for bearings of reference ties if not referenced to magnetic north.

NORTH This recovery completed May 14, 1998.

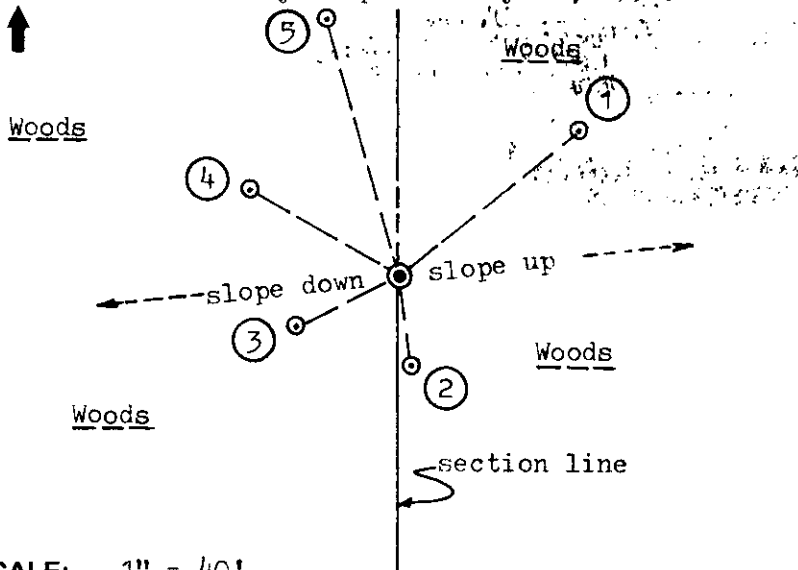

SCALE: 1" = 40'

Unless otherwise indicated, all bearing tree ties are to a .25" dia. by 2.5" long PK nail with a 1.25" dia. steel washer driven into unblazed right face and a .25" dia. by 2.5" long PK nail with a 2" dia. steel washer stamped 'BT' is also driven into unblazed face of bearing tree at DBH; the basis for measured bearings is magnetic to nearest degree and all tie distances are horizontal measure to nearest 1/100th feet.

WITNESS MONUMENT TIES:

- ① New BT 7" Mr N51°E 47.85' to PK nail/washer in left face of center trunk of cluster.
- ② New BT 9" Pj S05°E 18.87'.
- ③ New BT 10" Bw S65°W 24.29'.
- ④ New BT 15" Pr N60°W 36.61' to PK nail/washer in left face.
- ⑤ New BT 6" Mr N16°W 56.77' (SE trunk of a cluster of five).

Note: Standard white poly 'T' marker post set 6" West of corner.

LAND SURVEYOR CERTIFICATION:

I, William C. Rohde, hereby certify that I am a duly licensed Professional Land Surveyor in Wisconsin, that this USPLS monument location was determined by me or under my direction and control, and that this U.S. Public Land Survey Monument Location Record is true and correct to the best of my knowledge and belief.

William C. Rohde Date: 5-17-98
Signature


This form is intended to fulfill requirements of Chapter A-E 7.08 (3)(a)(b)(c)(d)(e)(f)(g)(h)(i) U.S. Public Land Survey Monument Location Record, Wisconsin Administrative Code. Use reverse side for geodetic location data and/or continuation purposes.

	11		

SECTION LOCATION MAP

INDEX NO. G 17
3705102000

INDEX NO.

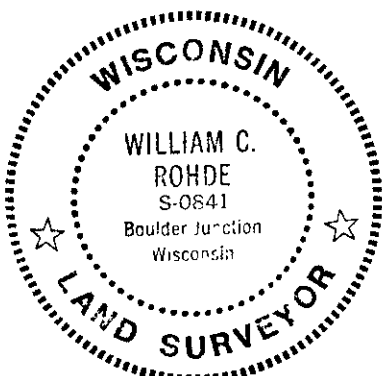

RLS SEAL

SHEET NO. 1 OF 1