


U.S. PUBLIC LAND SURVEY MONUMENT RECORD

Note: This form is intended and designed to fulfill all requirements of Wisconsin Administrative Code, Chapter A-E 7.08 U.S. Public Land Survey Monument Record (3) (a) (b) (c) (d) (e) (f) (g) (h) (i). An additional sheet may be added if necessary to conform with said requirements.

(a) Corner location: Township 37 North
 Range 6 East/West
 Town/City/Village Cassian
 County Oneida

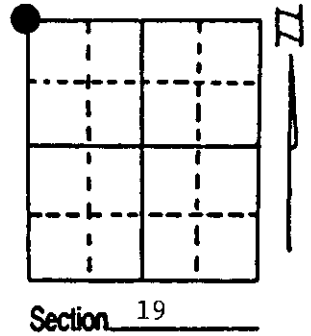

(b) (f) (g) (h) Description of monument found at this corner and if it was accepted, state all evidence (material, testimonial, occupational, plats, records, other monuments) used as a basis for accepting. If not accepted or if nothing was found, state evidence used as basis for establishing location. If reestablished through lost corner proportionate methods, indicate all monuments, distances and directions used to establish. Indicate type of monument found or set and sign post.

9/1860 - Alfred Millard established this corner at 80.00 chains and set a wood post with three BTs:
 5" Tamarack, N77 1/2°E, 11 Links (7.26')
 10" Tamarack, S13°E, 9 Links (5.94')
 8" Tamarack, S22°W, 22 Links (14.52')
 1.33 chains North to South bank of Tomahawk River.


1937 - Vern Maine restored corner.

11/10/1994 - Milo E. Stefan found 2" x 60" iron pipe with brass cap with 6" x 6" Cedar post along side and large post point. South bank of Tomahawk River, North approximately 90'. We made four new BTs and set plastic sign post.

(c) (d) (e) Plan view of corner with ties to at least 4 witness monuments. If in disagreement with previously established corner, show the distances between the two corners and also indicate the ties to the disputed corner.

- 1) 2" x 60" Iron Pipe/Brass Cap.
- 2) 12" Red Maple, N4°E, 21.42'
- 3) 14" Black Ash, N74°E, 56.48'
- 4) 10" Red Maple, S6°W, 39.05'
- 5) 8" Red Maple, N50°W, 32.74'
- 6) Plastic Sign Post, South, 1.0'

Distances to nail in side of BTs.
 Stump blazes scribed "BT".
 Small creek 5' West of corner.

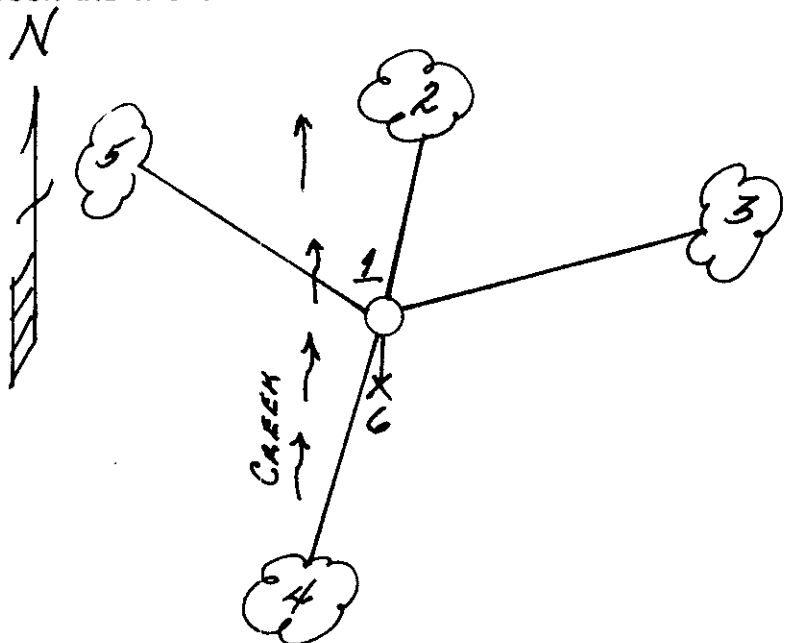

(i) I, Milo E. Stefan
 (type or print name) certify that the corner location on this record was determined by me or under my direction and control and that this U.S. Public Land Survey Monument Record is correct and complete to the best of my knowledge and belief.

Milo E. Stefan
 Signature

November 20, 1994
 Date



Index No. N-1