U.S. PUBLIC LAND SURVEY MONUMENT RECORD

Note: This form is intended and designed to fulfill all requirements of Wisconsin Administrative Code, Chapter A-E 7.08 U.S. Public Land Survey Monument Record (3)(a)(b)(c)(d)(e)(f)(g)(h)(i). An additional sheet may be added if necessary to conform with said requirements.

(a) CORNER LOCATION:

W 1/4 corner of Sec. 21

Township 37 North

Range 5 East

Town/~~City~~ Little Rice

State Plane Coordinates

X --

Y --

Datum Base --

County of Oneida

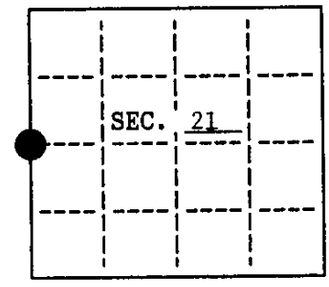

(b) HISTORY OF ORIGINAL CORNER ESTABLISHMENT

Original Surveyor: Jos. Jenkins

Date of Survey: Commenced June, 1863

Completed

Original B.T.'S

10" Birch, N10°W, 18 lks.

10" Birch, S87°E, 18 lks.

(b)(f)(g)(h) Description of monument found at this corner and if it was accepted, state all evidence (material, testimonial, occupational, plats, records, other monuments) used as a basis for accepting. If not accepted or if nothing was found, state evidence used as basis for establishing location. If reestablished through lost corner proportionate methods, indicate all monuments, distances and directions used to establish. Indicate type of monument and sign post found or set.

May, 1994 - I found a 1-1/4" iron pipe and 3" squared wood post at a location determined by doubling through the Northwest Section Corner and North 1/16 Corner. I found no original evidence. I replaced said iron pipe with an Oneida County Aluminum Monument and plastic signpost.

(c)(d)(e) Plan view of corner with ties to at least 4 witness monuments. If in disagreement with previously established corner, show the distances between the two corners and also indicate the ties to the disputed.

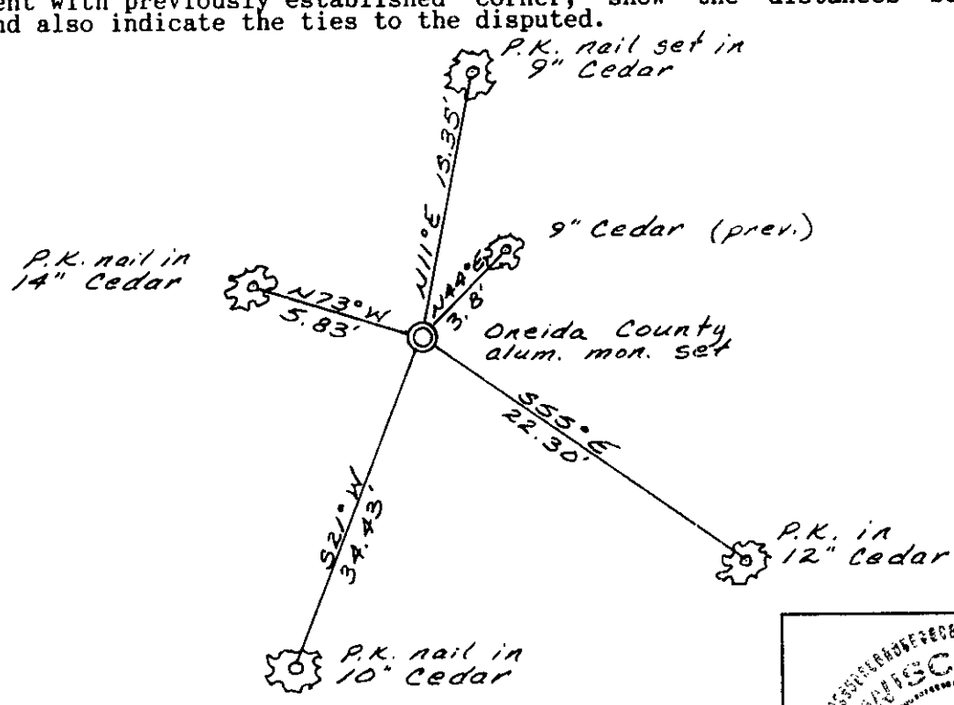

(i) I, Charles E. Winkler S-1431 hereby certify that the corner location on this record was determined by me or under my direction and control and that this U.S. Public Land Survey Monument Record is correct and complete to the best of my knowledge and belief.

Charles E. Winkler 11/7/94

Signature Inman-Foltz & Associates, Inc. Date

WISCONSIN CHARLES E. WINKLER MINOCQUA, WI LAND SURVEYOR

INDEX NO. P-6

3705202000