PUBLIC LAND SURVEY MONUMENT RECORD

Note: This form is intended and designed to fulfill all requirements of Wisconsin Administrative Code, Chapter A-E 7.08 U.S. Public Land Survey Monument Record (3) (a) (b) (c) (d) (e) (f) (g) (h) (i). An additional sheet may be added if necessary to conform with said requirements.

(a) CORNER LOCATION:

Plane Coordinates

1/4 Cor. of Secs. 22 & 23

X:

Township 37 North

Υ:

Range 5 East of the 4th P.M.

Datum:

Town of Little Rice

County of Oneida

(b) HISTORY OF ORIGINAL CORNER ESTABLISHMENT

Original Surveyor: Joseph Jenkins

Original Accessories:

Signature

Date of Survey: Commenced June, 1865

SEC


22

Completed June, 1865


Spruce 6" N.35°E., 8 lks. Y. Pine 8" S.81°W., 23 lks.

(b) (f) (g) (h) Description of monument found at this corner and if it was accepted, state all evidence (material, testimonial, occupational, plats, records, other monuments) used as a basis for accepting. If not accepted or if nothing was found, state evidence used as basis for establishing location. If re-established through lost corner proportionate methods, indicate all monuments, distances and directions used to establish. Indicate type of monument and sign post found or set.

May 22, 2009: I found and accepted a distinct post hole surrounded by a rock cairn. I found the scribed GLO red pine stump at record bearing and distance. In the post hole, I set an aluminum post, 30 ins. long, 2-1/2 ins. diam. with Oneida Co. aluminum cap projecting 4 ins. above the ground. I established accessories as shown below and set a white plastic sign post bearing Southeast, 1 ft. dist.

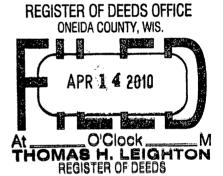

(c) (d) (e) Plan view of corner with ties to at least 4 witness monuments. If in disagreement with previously established corner, show the distances between the two

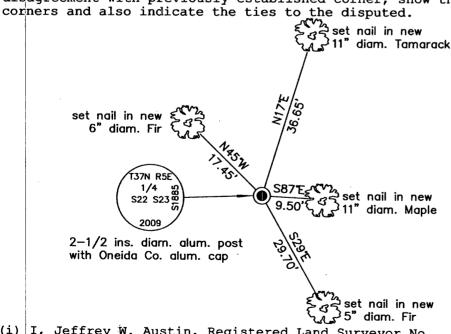

(i) I, Jeffrey W. Austin, Registered Land Surveyor No. S-1885, hereby certify upon honor that the corner location on this record was determined by me or under my direction and control and that this U.S. Public Land Survey Monument i\$\ Xe Record i correct and complete to the best of my knowledge

MAR 30, 2010



NO SCALE

3705222000

NO.