

U.S. PUBLIC LAND SURVEY MONUMENT LOCATION RECORD

Recorders Data

CORNER: West 1/4 SECTION: 24 TOWNSHIP 37 NORTH RANGE 5 EAST/WEST

FOR M.C. CORNER INDICATE: NAME OF WATERWAY N/A SECTION LINE N/A

(CITY)(VILLAGE)(TOWN) OF: Little Rice COUNTY OF: Oneida


Description of monument found or placed and all other evidence used as a basis for monument location; including all monuments and related measurements required if the corner location is reestablished by lost corner proportionate methods. Also indicate name of original surveyor, survey date, corner monument set and established bearing trees, witness or reference monuments with ties from available records.

No monument observed nor detected with electronic metal locator at this corner location area within an existing roadway intersection, so I drove a 3/4" dia. by 12" long iron rod flush in the roadway pavement 30.00' East of an old 1 1/4" dia. iron pipe witness monument found with uncapped top 10" above matted marsh grass surface, and with an old squared wood marker post tipped 30° North 12" from the old iron pipe, scribed "1/4 S.W.C." on East face and "1/4 S" on other faces. I drove a 1" dia. by 48" long iron pipe with a standard cap in top stamped Reference Mark, 24" above grade. The corner falls in the centerline joint of the existing pavement.

In 1863, Jenkins/GLO, set a wood post as the original corner and marked BTs, a 14" Pj N30°E 60 lks and a 10" Pj N56°W 13 lks, all of which are now obliterated. No other corner evidence was observed nor detected within a 1 chain radius of the corner location established.

The old iron pipe witness monument and squared wood marker post found West of the existing roadway is identical in placement as that found for the SW, West 1/4 and NW corners of Section 25 southerly along County Highway 'Y', and as noted by 1953 Plat of Survey Drawing No. 1397-1/ Genisot Engineering by Wincentzen, so I reset, this corner location in the same manner accordingly, as the best location without any other evidence of reliable reference. This recovery completed June 15, 1998; there were no witnesses, other than vehicle drive-bys.

Plan view map of monument location with bearing and distance ties to a minimum of four(4) described witness or reference monuments of concrete, natural stone, iron, live bearing trees or equivalent material. If applicable, also show a minimum of two(2) bearing and distance ties to any other monument found and not accepted; including the bearing and distance from the accepted monument. Indicate the basis for bearings of reference ties if not referenced to magnetic north.

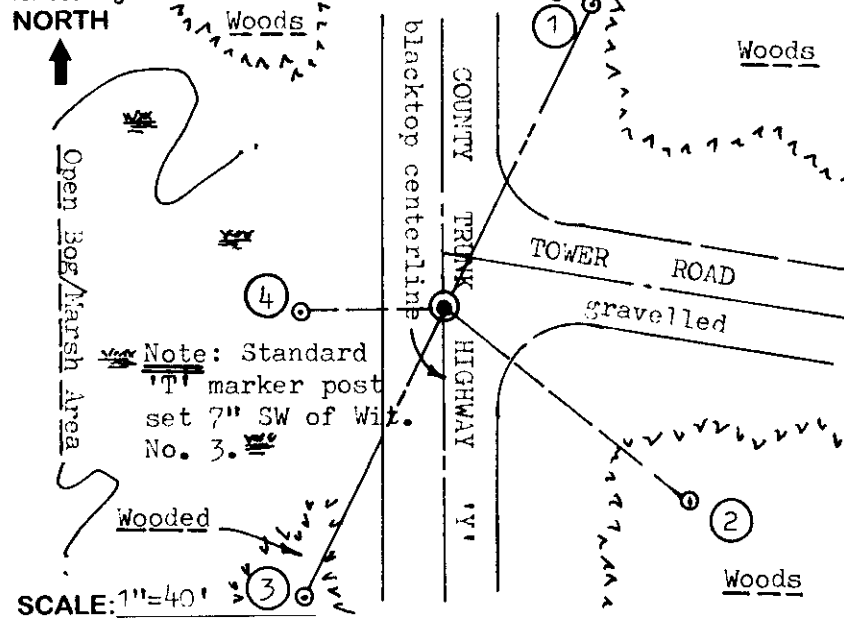

WITNESS MONUMENT TIES:


- ① 1" dia. by 24" long iron pipe set with standard Reference Mark cap flush, N26°E 70.96'.
- ② New BT 17" Pw S51°E 65.08' with standard BT sign nailed to NW face.
- ③ 1" dia. by 30" long iron pipe set with standard Reference Mark cap 1" above grade, S26°W 67.20'.
- ④ Old 1 1/4" dia. iron pipe witness monument found, with new 1" dia. by 48" long iron pipe driven into it with standard Reference Mark cap 24" above grade, West 30.00'.

Unless otherwise indicated, all bearing tree ties are to a .25" dia. by 2.5" long PK nail with a 1.25" dia. steel washer driven into unblazed right face and a .25" dia. by 2.5" long PK nail with a 2" dia. steel washer stamped 'BT' is also driven into unblazed face of bearing tree at DBH; the basis for measured bearings is magnetic to nearest degree and all tie distances are horizontal measure to nearest 1/100th feet.

LAND SURVEYOR CERTIFICATION:

I, William C. Rohde, hereby certify that I am a duly licensed Professional Land Surveyor in Wisconsin, that this USPLS monument location was determined by me or under my direction and control, and that this U.S. Public Land Survey Monument Location Record is true and correct to the best of my knowledge and belief.

William C. Rohde Date: 6-17-98
Signature

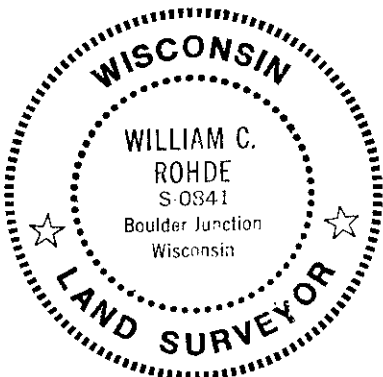

RLS SEAL

SHEET NO. 1 OF 1

	24		

INDEX NO.

This form is intended to fulfill requirements of Chapter A-E 7.08 (3)(a)(b)(c)(d)(e)(f)(g)(h)(i) U.S. Public Land Survey Monument Location Record, Wisconsin Administrative Code. Use reverse side for geodetic location data and/or continuation purposes.

SECTION LOCATION MAP

INDEX NO. P 21

3705 23 20 00