

CERTIFIED LAND CORNER RESTORATION

State of Wisconsin }
County of Oneida } ss.

I, John H. Fisher, do hereby certify that on the 6th day of July, 1981, I found evidence of the northwest corner of Section 4 Township 36N Range 5E, Fourth Principal Meridian, as described hereon; and that from this evidence I established a new monument and accessories as described hereon to perpetuate the original location of this corner:

Description of original monument and accessories and subsequent restorations:

The original Gov't. survey was performed by Alfred Millard, Deputy Surveyor in Oct., 1860

- 8" Tamarack N80°E, 23 links
- 8" Tamarack S12°E, 9 links
- 5" Tamarack S50°W, 92 links
- 5" Tamarack N70°W, 27 links


Description of corner evidence found:

W.C.D. 2" iron pipe with brass cap. (1940)


Description of monument and accessories I established to perpetuate the location of this corner:

Set:

- Tamarack Post
- 8" Tamarack N30°E, 57.6 feet
- 6" Tamarack N25°W, 73.0 feet
- 4" Tamarack, S70°W, 31.2 feet

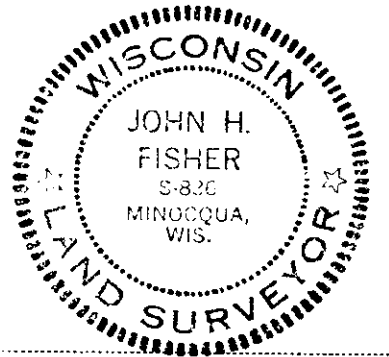

*Corner data checked with records & accepted as correct
John H. Fisher, Oneida Surveyor*

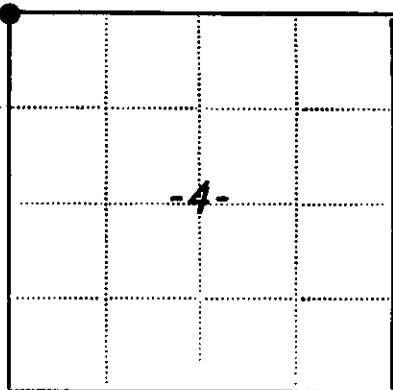

● - Corner monument restored
□ -

Resident witnesses.....

Dated at Minocqua Wisconsin, this 31 day of July 1981.

Signature John H. Fisher Title Registered Land Surveyor
(County Surveyor, Registered Land Surveyor, or other duly authorized official)

Surveyors Registration No. S-836

Office of Registrar of Deeds County of Oneida

I hereby certify that the within instrument was filed in this office for record on the 25th day of August 1982, and was filed in Book No. Page No. of County Records.

Signature Doris Verage Kuehn Title Registrar of Deeds

Township....., Range....., Section....., Index No....., Page No.....