

CERTIFIED LAND CORNER RESTORATION

State of Wisconsin }  
County of Oneida } ss.

I, John H. Fisher, do hereby certify that on the 10th day of June, 1981, I found evidence of the north one quarter corner of Section 4, Township 36N, Range 56E, Fourth Principal Meridian, as described hereon; and that from this evidence I established a new monument and accessories as described hereon to perpetuate the original location of this corner:

Description of original monument and accessories and subsequent restorations:

The original Gov't. survey was performed by Alfred Millard, Deputy Surveyor in Oct. 1860.

Set wood post

3" Tamarack N47°E, 50 links  
3" Tamarack S40°W, 104 links


Description of corner evidence found:

W.C.D. 2" iron pipe with brass cap (1940)


Description of monument and accessories I established to perpetuate the location of this corner:

Set:

Tamarack post  
5" Tamarack S80°E, 24.8 feet  
3" Tamarack N8°W, 85.3 feet  
4" Tamarack, S32°E, 55.1 feet

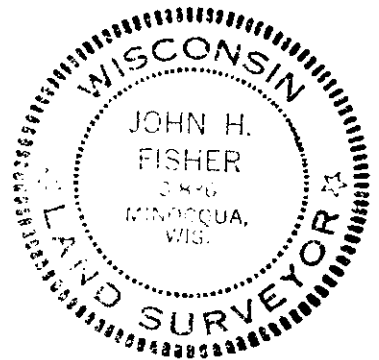

Corner data checked with record & accepted as correct  
G. H. & H. H. at Oneida Land Survey

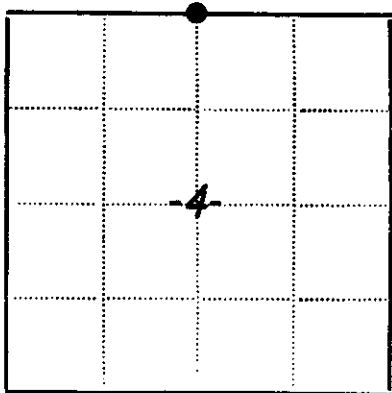

● - Corner monument restored  
□ -

Resident witnesses

Dated at Minocqua Wisconsin, this 31 day of July 1981.

Signature John H. Fisher Title Registered Land Surveyor  
(County Surveyor, Registered Land Surveyor, or other duly authorized official)

Surveyors Registration No. S-836

Office of Registrar of Deeds County of Oneida

I hereby certify that the within instrument was filed in this office for record on the 25th day of August 1982, and was filed in Book No. Page No. of County Records.

Signature Doris Verage Kuehn Title Registrar of Deeds

Township, Range, Section, Index No., Page No.

A-11