

U. S. PUBLIC LAND SURVEY MONUMENT RECORD


Note: This form is intended and designed to fulfill all requirements of Wisconsin Administrative Code, Chapter A-E 7.09 U.S. Public Land Survey Monument Record. It is to be filled in by the landowner. An additional sheet may be added if necessary to conform with said requirements.

(a) Corner location: Township 37 North

Range 6 East

Town of Cassian

Oneida County, Wisconsin

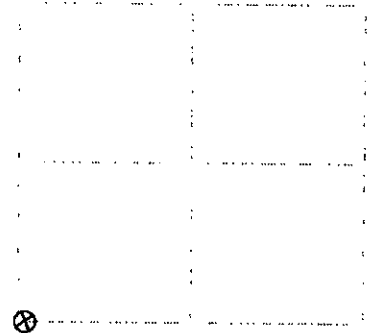

Section 1

(b) Forgive: Description of monument found at this corner and if it was accepted, state all evidence (material, testimonial, occupational, plats, records, other monuments) used as a basis for accepting. If not accepted or if nothing was found, state evidence used as basis for establishing location. If reestablished through lost corner proportionate methods, indicate all monuments, distances and directions used to establish. Indicate type of monument found or set and sign post.

June-July, 1868: Joseph Jenkins, US deputy surveyor notes the following: 50.00 set post for cor. to secs: 1,2,11&12: tamarac 12 N42W, 13; tamarac 10 N42E, 13.


December 23, 1926: Maine page 148 notes the following: SW section corner section 1, 37-6: set official iron pipe, brass cap stamped, located by steps of crag, 6 1/2' marks plain viz: tam 12 N42W, 13; tam 10 N42E, 13. Found points of 3 old stakes. Marked oak 8 1/2' viz: spruce 5 south, 31-1/2; spruce 5 S85E, 44-1/2; spruce 3 N5E, 31; spruce 4 N69W, 29-1/2.

November 22, 1990: I found and accepted a 2-1/2" dia. iron post with brass cap 29" above ground marked as shown below. I found the following witnesses: broken scribed spruce/maine 7" N5E, 20.9 feet; broken scribed spruce/maine 7" S34E, 29.7 feet; old rotted stump/maine 55E, 20.8 feet; old stump with axe marks maine N69W, 18.9 feet. I established the following witnesses: set nail in tamarack 7" N75E, 22.96 feet; set nail in tamarack 7" S43E, 22.33 feet; set nail in tamarack 6" S36W, 19.46 feet; set nail in tamarack 5" N62W, 23.60 feet; set plastic sign post north, 1 foot.

(c) Provide Plan view of corner with ties to at least four witness monuments. If in disagreement with previously established corner, show the distances between the two corners and also indicate the ties to the disputed corner.

1. nail in tamarack 7" N75E, 22.96 feet.
2. nail in tamarack 7" S43E, 22.33 feet.
3. nail in tamarack 6" S36W, 19.46 feet.
4. nail in tamarack 5" N62W, 23.60 feet.

(not to scale)

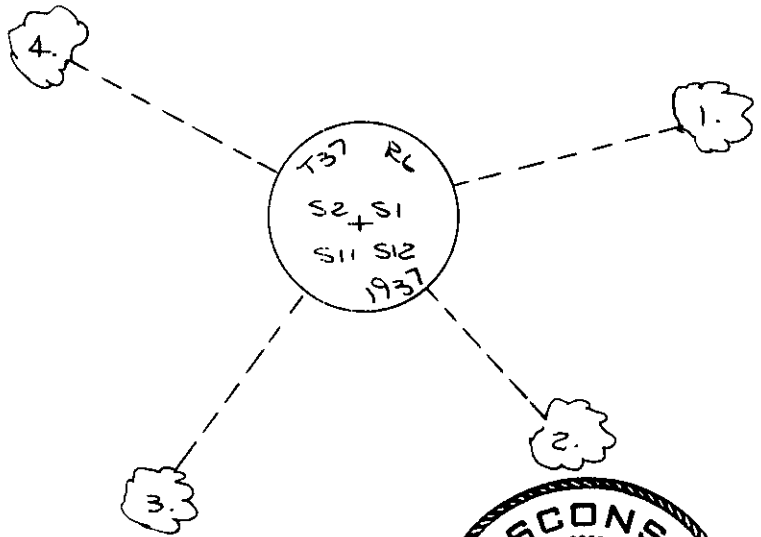

I, Jeffrey W. Austin, Registered Land Surveyor S-1885 certify that the corner location of this record was determined by me or under my direction and control and that this U.S. Public Land Survey Monument Record is correct and complete to the best of my knowledge and belief.

Jeffrey W. Austin
 NOVEMBER 30, 1990

Index no. E-21

3706020000