


U.S. PUBLIC LAND SURVEY MONUMENT RECORD

Note: This form is intended and designed to fulfill all requirements of Wisconsin Administrative Code, Chapter A-E 7.08 U.S. Public Land Survey Monument Record (3) (a) (b) (c) (d) (e) (f) (g) (h) (i). An additional sheet may be added if necessary to conform with said requirements.

(a) Corner location: Township 37 North
 Range 6 East/West

Town/City/Village Cassian

County Oneida

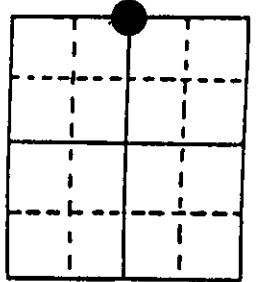

Section 10

(b) (f) (g) (h) Description of monument found at this corner and if it was accepted, state all evidence (material, testimonial, occupational, plats, records, other monuments) used as a basis for accepting. If not accepted or if nothing was found, state evidence used as basis for establishing location. If reestablished through lost corner proportionate methods, indicate all monuments, distances and directions used to establish. Indicate type of monument found or set and sign post.


1863 - Joseph H. Jenkins established this corner, set a wood post with BTs:
 6" Birch, N8°E, 25 Links (16.50') 7" Aspen, S6°E, 23 Links (15.18')

1/14/1937 - Vern Maine restored this corner by Lost Methods - 38.45½ chains East and West. He placed a 2" x 60" iron pipe with brass cap and made three new BTs:
 10" Red Pine, N41°E, 37.5 Links (24.75')
 6" Red Pine, N19°W, 28.9 Links (19.07')
 6" Red Pine, N67°W, 9.8 Links (6.47')

6/10/1996 - Milo E. Stefan found Maines monument in excellent condition with two BTs cut down and one okay (6" R.P., N67°W, 9.8 Links). We made three new BTs and placed a plastic sign post.

(c) (d) (e) Plan view of corner with ties to at least 4 witness monuments. If in disagreement with previously established corner, show the distances between the two corners and also indicate the ties to the disputed corner.

- 1) 2" x 60" Iron pipe/B.C.
- 2) 10" Red Pine, N39°E, 29.89'
- *3) 14" Red Pine Stump, N41°E, 24.75'
- 4) 8" Tamarack, N68°E, 54.08'
- *5) 18" Red Pine, N67°W, 6.47'
- 6) 12" White Pine, N41°W, 36.55'
- *7) 12" Red Pine Stump, N19°W, 19.07'
- 8) Plastic Sign Post, North, 1.0'

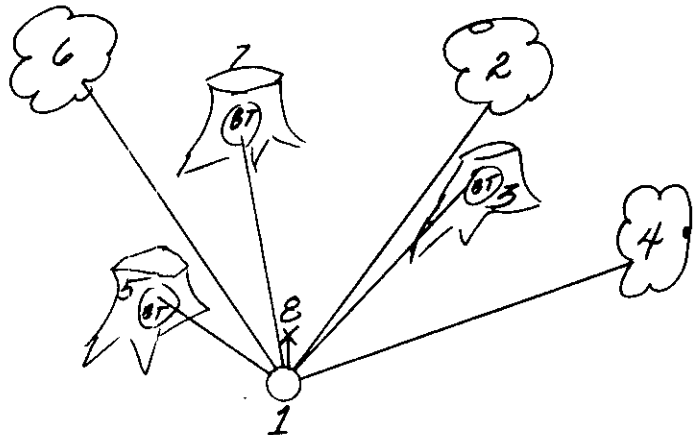

*Maines BT and remains of.

Distances from nail in side of BTs
 Stump blaze scribed "BT"
 BT tags on face of each BT

(i) I, Milo E. Stefan
 (type or print name) certify that the corner location on this record was determined by me or under my direction and control and that this U.S. Public Land Survey Monument Record is correct and complete to the best of my knowledge and belief.

Milo E. Stefan
 Signature

June 18, 1996
 Date

Milo E. Stefan
 Stamp

Stamp
 3706030020

Index No. E-15