U.S. PUBLIC LAND SURVEY MONUMENT RECORD

Note: This form is intended and designed to fulfill all requirements of Wisconsin Administrative Code, Chapter A-E 7.08 U.S. Public Land Survey Monument Record (3) (a) (b) (c) (d) (e) (f) (g) (h) (i). An additional sheet may be added if necessary to conform with said requirements.

(a) Corner location: Township 37 North

Range 6 East/~~West~~

Town/~~City/Village~~ Cassian

County Oneida

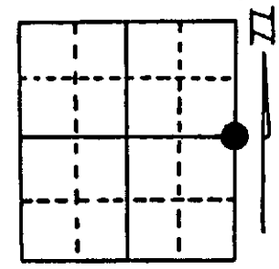

Section 6

(b) (f) (g) (h) Description of monument found at this corner and if it was accepted, state all evidence (material, testimonial, occupational, plats, records, other monuments) used as a basis for accepting. If not accepted or if nothing was found, state evidence used as basis for establishing location. If reestablished through lost corner proportionate methods, indicate all monuments, distances and directions used to establish. Indicate type of monument found or set and sign post.

1863 - Joseph H. Jenkins established this corner at 38.70 chains from the North, set Quarter Post and two BTs:
14" Y. Pine, S12°E, 12 Links (7.92') 15" White Pine, S52°W, 52 Links (34.32')

1937 - V. Maine restored this corner and set a 2" x 60" iron pipe/brass cap.

10/27/94 - Milo E. Stefan found Maine's monument in collar of stone. We made four new BTs and set plastic sign post. Monument falls on North bank of old grade.

(c) (d) (e) Plan view of corner with ties to at least 4 witness monuments. If in disagreement with previously established corner, show the distances between the two corners and also indicate the ties to the disputed corner.

1) 2" x 60" iron pipe/brass cap.
2) 8" Black Spruce, S30°E, 50.82'.
3) 8" Tamarack, S20°W, 70.63'.
4) 14" White Pine, S84°W, 104.39'.
5) 6" Red Oak, N10°W, 61.44'.
6) Plastic Sign Post, North, 1.0'.

Distances to nail in side of BTs.
Stump blazes scribed "BT".

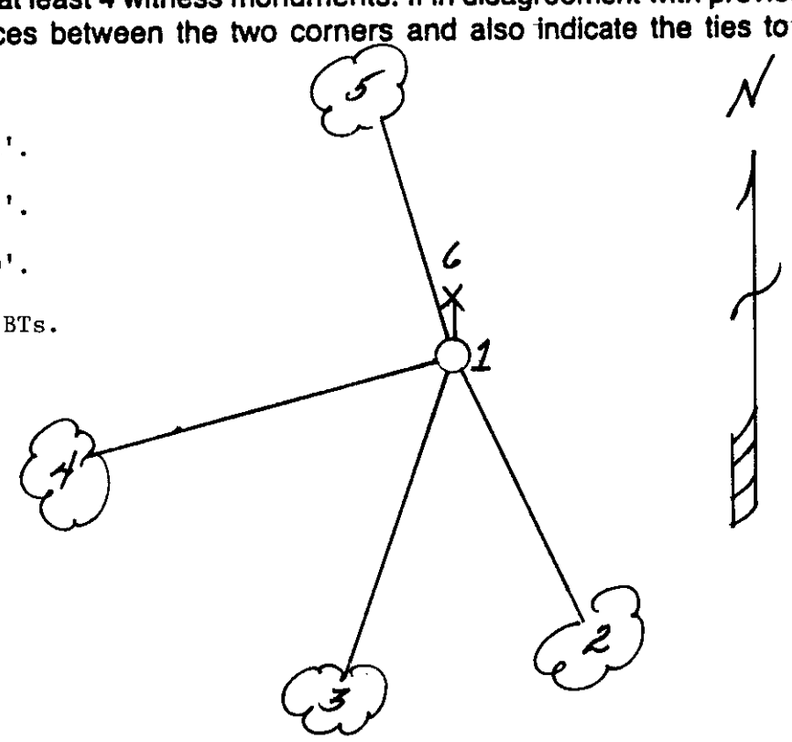

(i) I, Milo E. Stefan **(type or print name) certify that the corner location on this record was determined by me or under my direction and control and that this U.S. Public Land Survey Monument Record is correct and complete to the best of my knowledge and belief.**

Milo E. Stefan — October 30, 1994

Signature — Date

WISCONSIN MILO E STEFAN S-1558 RHINELANDER WIS. LAND SURVEYOR

Milo E. Stefan

3706062000

Index No. C-5