


U.S. PUBLIC LAND SURVEY MONUMENT RECORD

Note: This form is intended and designed to fulfill all requirements of Wisconsin Administrative Code, Chapter A-E 7.08 U.S. Public Land Survey Monument Record (3) (a) (b) (c) (d) (e) (f) (g) (h) (i). An additional sheet may be added if necessary to conform with said requirements.

(a) Corner location: Township 37 North
 Range 6 East/West

Town/City/Village Cassian

County Oneida

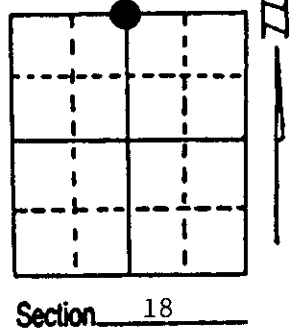


(b) (f) (g) (h) Description of monument found at this corner and if it was accepted, state all evidence (material, testimonial, occupational, plats, records, other monuments) used as a basis for accepting. If not accepted or if nothing was found, state evidence used as basis for establishing location. If reestablished through lost corner proportionate methods, indicate all monuments, distances and directions used to establish. Indicate type of monument found or set and sign post.

- 1863 - Joseph H. Jenkins established this corner at 35.12 chains. He set a wood post with two BTs:
 16" Tamarack, N46°W, 9 Links (5.94')
 12" Tamarack, S10°E, 39 Links (25.74')
- 11/20/1936 - V. Maine restored corner by Lost Methods. He set a cedar stake with two BTs:
 4" Spruce, N18°W, 16 3/4 Links (11.055')
 3 1/2" Spruce, S67°W, 21 1/2 Links (14.19')
- 1937 - Maine placed a 2" x 60" iron pipe/brass cap.
- 11/16/1994 - Milo E. Stefan found Maine's monument and northwest BT down. Southwest BT gone. Two Location Posters on down trees. We placed mound of stone around monument to firm it up, made four new BTs, placed Location Poster and set plastic sign post.

(c) (d) (e) Plan view of corner with ties to at least 4 witness monuments. If in disagreement with previously established corner, show the distances between the two corners and also indicate the ties to the disputed corner.

- 1) 2" x 60" Iron Pipe/Brass Cap.
- 2) 12" White Spruce, N6°E, 14.56'.
- 3) 12" Cedar, S16°W, 41.35'.
- 4) 14" Tamarack, S55°W, 23.58'.
- 5) 10" Tamarack, West, 22.61'.
- 6) 10" Black Spruce, S55°W, 7.0 1/2 Location Posters
- 7) Plastic Sign Post, NE, 1.5'.

Distances to nail in side of BTs.
 Stump blazes scribed "BT".

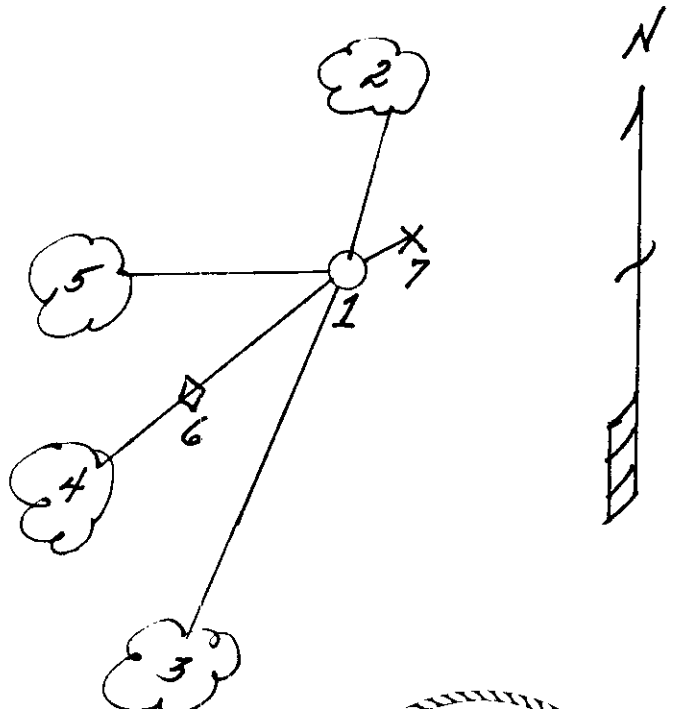

(i) I, Milo E. Stefan
 (type or print name) certify that the corner location on this record was determined by me or under my direction and control and that this U.S. Public Land Survey Monument Record is correct and complete to the best of my knowledge and belief.

Milo E. Stefan
 Signature

November 28, 1994
 Date



Index No. J-3

3706070020