


# U.S. PUBLIC LAND SURVEY MONUMENT RECORD

**Note:** This form is intended and designed to fulfill all requirements of Wisconsin Administrative Code, Chapter A-E 7.08 U.S. Public Land Survey Monument Record (3) (a) (b) (c) (d) (e) (f) (g) (h) (i). An additional sheet may be added if necessary to conform with said requirements.

(a) Corner location: Township 37 North  
 Range 6 East/West  
 Town/City/Village Cassian  
 County Oneida

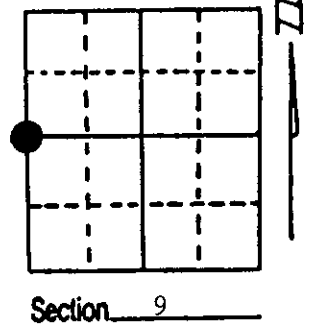


(b) (f) (g) (h) Description of monument found at this corner and if it was accepted, state all evidence (material, testimonial, occupational, plats, records, other monuments) used as a basis for accepting. If not accepted or if nothing was found, state evidence used as basis for establishing location. If reestablished through lost corner proportionate methods, indicate all monuments, distances and directions used to establish. Indicate type of monument found or set and sign post.

- 1863 - Joseph H. Jenkins established this corner at 40.00 chains, set a wood post with two BTs: 6" Tamarack, N55°E, 6 Links (3.96')  
 12" Jack Pine, N44°W, 40 Links (26.40')
- 12/15/1936 - Vern Maine found original Jack Pine BT/Jack Pine stake. He made two new BTs:  
 5" Jack Pine, N87°W, 67 3/4 Links (44.72')  
 8" Jack Pine Stub, S27°E, 46 1/2 Links (30.69')  
 (We were not aware of these 11/10/1994 - MES)
- 1937 - Vern Maine restored this corner and set a 2" x 60" iron pipe/brass cap.
- 11/10/1994 - Milo E. Stefan found Maine's monument, made new BTs and set a plastic sign post.

(c) (d) (e) Plan view of corner with ties to at least 4 witness monuments. If in disagreement with previously established corner, show the distances between the two corners and also indicate the ties to the disputed corner.

- 1) 2" x 60" Iron Pipe/Brass Cap.
  - 2) 6" Black Spruce, N44°E, 17.48'
  - 3) 14" Red Pine, S12°W, 13.95'
  - 4) 18" White Pine, S75°W, 36.00'
  - 5) 6" Black Spruce, N40°W, 34.42'
  - 6) Plastic Sign Post, NE., 1.0'
- Distances to nail in side of BTs.  
 Stump blaze scribed "BT".

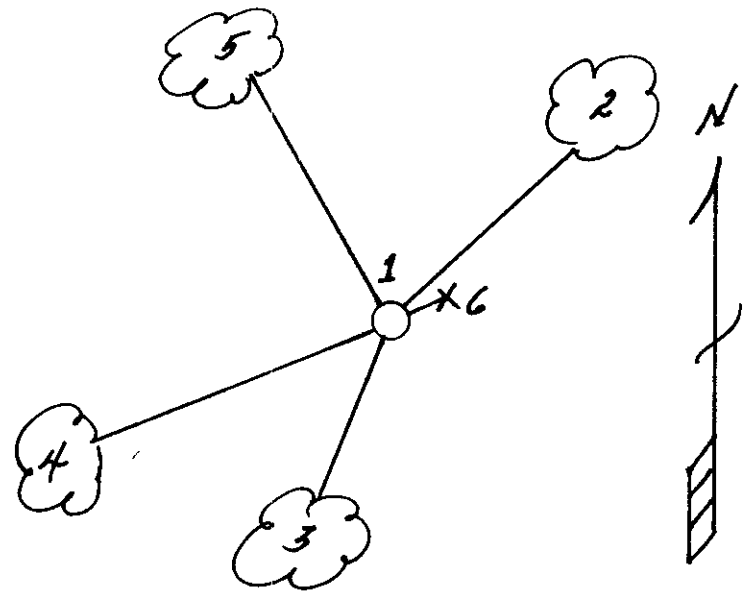

(i) I, Milo E. Stefan  
 (type or print name) certify that the corner location on this record was determined by me or under my direction and control and that this U.S. Public Land Survey Monument Record is correct and complete to the best of my knowledge and belief.

Milo E. Stefan Signature  
 November 20, 1994 Date



3706082000

Index No. G-9