

CERTIFIED LAND CORNER RESTORATION

State of Wisconsin }
County of ONEIDA } ss.

I JEROME N. KRAEMER, do hereby certify that on the 20th day of October, 1981, I found evidence of the one-quarter corner of Sections 10 and 15 Township 37 north, Range 6 East, Fourth Principal Meridian, as described hereon; and that from this evidence I established a new monument and accessories as described hereon to perpetuate the original location of this corner:

Description of original monument and accessories and subsequent restorations:

Original corner, a wood post established in 1863 by J. H. Jenkins, Government Deputy Surveyor.

Birch 6 N8°E 25
Aspen 7 S6°E 23

From county record book, V. M. Maine, County Surveyor Nov. 16, 1936 at orig. Gov't. 1/4 stk between Secs. 10 and 15. Found mound of rock, removed same and found point of orig. Post rotted to fibers. Checked for orig. Birch B.T. Found where it stood, remains of roots and charred wood. Set official corner and marked B.T.'s viz; Y.P. stp 10 N61°W, 1.01. Blk Oak 2-1/2 N35°E .04-1/2"


Description of corner evidence found:

I found a 2" diameter iron pipe protruding 24" above ground level with a round tablet stamped "T37, R6, S10, 1/4, S15, VM, 1937". A 10" square pine post scribed 1/4 M stands by iron pipe. A blaze on an Oak 8" bears N44°E, 2.89 feet from iron pipe.

Description of monument and accessories I established to perpetuate the original location of this corner:

Based on recorded and recovered evidence, I accept existing 2" diameter iron pipe with stamped tablet as best available local evidence of corner. Set PK nail in closed blaze and measured to same PK nail in Oak 8" N44°E, 2.89 feet. Blazed and scribed following new bearing trees. Set PK nail in lower blaze and measured distance to same PK nail.

Oak 10" N54°E 23.41 feet
Maple 5" S32°E 26.16 feet

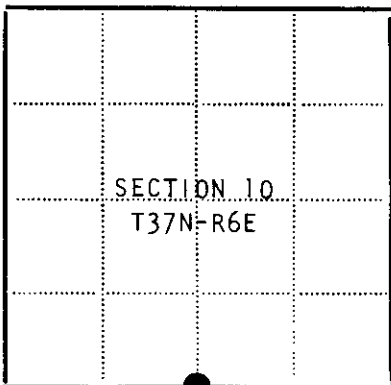

● = Corner monument restored
□ =

Resident witnesses.....

Dated at Minocqua Wisconsin, this 12th day of March 1982.

Signature Jerome N. Kraemer Title Reg. Land Surveyor
(County Surveyor, Registered Land Surveyor, or other duly authorized official)

Surveyors Registration No. S1448

Office of Reg. of Deeds County of Oneida
I hereby certify that the within instrument was filed in this office for record on the 11 day of June 1986, and was filed in Book No. _____ Page No. _____ of County Records.

Signature Edward P. Piro Title Dep. Reg. Deeds

Township _____, Range _____, Section _____, Index No. _____, Page No. _____