


# U.S. PUBLIC LAND SURVEY MONUMENT RECORD

Note: This form is intended and designed to fulfill all requirements of Wisconsin Administrative Code, Chapter A-E 7.08 U.S. Public Land Survey Monument Record (3) (a) (b) (c) (d) (e) (f) (g) (h) (i). An additional sheet may be added if necessary to conform with said requirements.

(a) Corner location: Township 37 North  
 Range 6 East/West

Town/City/Village Cassian

County Oneida

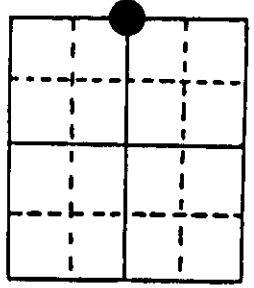

Section 14

(b) (f) (g) (h) Description of monument found at this corner and if it was accepted, state all evidence (material, testimonial, occupational, plats, records, other monuments) used as a basis for accepting. If not accepted or if nothing was found, state evidence used as basis for establishing location. If reestablished through lost corner proportionate methods, indicate all monuments, distances and directions used to establish. Indicate type of monument found or set and sign post.

1863 - Joseph H. Jenkins called Quarter Corner in lake.

11/13/1936 - Vern Maine found distance from Section Corner to Section Corner to be 82.95 chains. He therefore established this corner West of the M.C.


6/10/1996 - Milo E. Stefan found Maines monument in good condition with much bulldozing going on in area. To preserve this corner, we made BTs and set plastic sign post.

/// One should test the position prior to using it as the Quarter Corner ///

(c) (d) (e) Plan view of corner with ties to at least 4 witness monuments. If in disagreement with previously established corner, show the distances between the two corners and also indicate the ties to the disputed corner.

- 1) 2" x 60" Iron pipe/B.C.
- 2) 22" Red Pine, S65°E, 86.55'
- 3) 12" Red Oak, S40°W, 51.19'
- 4) 8" White Pine, S78°W, 95.61'
- 5) 6" White Pine, N8°W, 39.79'
- 6) Plastic sign post, South, 1.0'

Distances from nail in side of BTs  
 Stump blaze scribed "BT"  
 BT tags on face of each BT

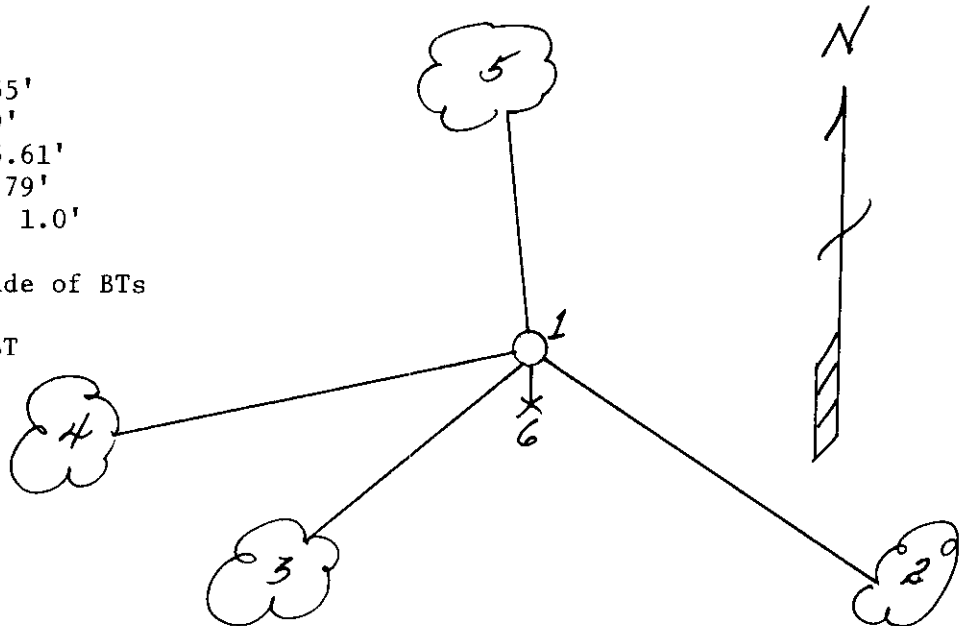

(i) I, Milo E. Stefan  
 (type or print name) certify that the corner location on this record was determined by me or under my direction and control and that this U.S. Public Land Survey Monument Record is correct and complete to the best of my knowledge and belief.

Milo E. Stefan  
 Signature

June 18, 1996  
 Date



Index No. J-19

Stamp  
 3706110020