

U.S. PUBLIC LAND SURVEY MONUMENT RECORD


Note: This form is intended and designed to fulfill all requirements of Wisconsin Administrative Code, Chapter A-E 7.08 U.S. Public Land Survey Monument Record (3) (a) (b) (c) (d) (e) (f) (g) (h) (i). An additional sheet may be added if necessary to conform with said requirements.

(a) Corner location: Township 37 North

Range 6 East/West

Town/City/Village Cassian

County Oneida

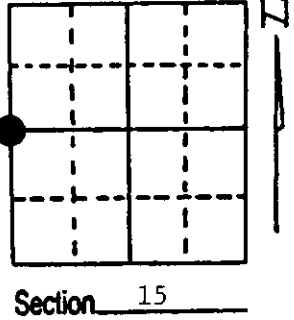

(b) (f) (g) (h) Description of monument found at this corner and if it was accepted, state all evidence (material, testimonial, occupational, plats, records, other monuments) used as a basis for accepting. If not accepted or if nothing was found, state evidence used as basis for establishing location. If reestablished through lost corner proportionate methods, indicate all monuments, distances and directions used to establish. Indicate type of monument found or set and sign post.


- 1860 - Joseph H. Jenkins established this corner and set a wood post with two BTs:
6" Aspen, S65°E, 15 Links (9.90') 5" Aspen, S52°W, 4 Links (2.64')
- 10/27/1936 - Vern Maine restored this corner and set a Red Pine Stake with two BTs:
8" White Pine Stub, N8°W, 36 Links (23.76') 9" Red Pine, S32°E, 66 Links (43.56')
- 1937 - Maine placed an iron pipe/brass cap.
- 11/16/1994 - Milo E. Stefan found Maine's monument in mound of stone and Southeast BT alive and in good condition. We made three new BTs and set a Plastic Sign Post.

(c) (d) (e) Plan view of corner with ties to at least 4 witness monuments. If in disagreement with previously established corner, show the distances between the two corners and also indicate the ties to the disputed corner.

- 1) 2" x 60" Iron Pipe/Brass Cap.
- 2) 10' x 4' x 3' High Grey Granite Boulder/"+" , N79°E, 85.23'.
- 3) 18" Red Pine, S32°E, 44.46'-Maines.
- 4) 5" Red Oak, S42°W, 31.54'.
- 5) 8" Red Oak, N48°W, 102.22'.
- 6) Plastic Sign Post, North, 1.0'.

Distance to nail in side of BTs, or "+" on boulder.

Stump blaze scribed "BT".

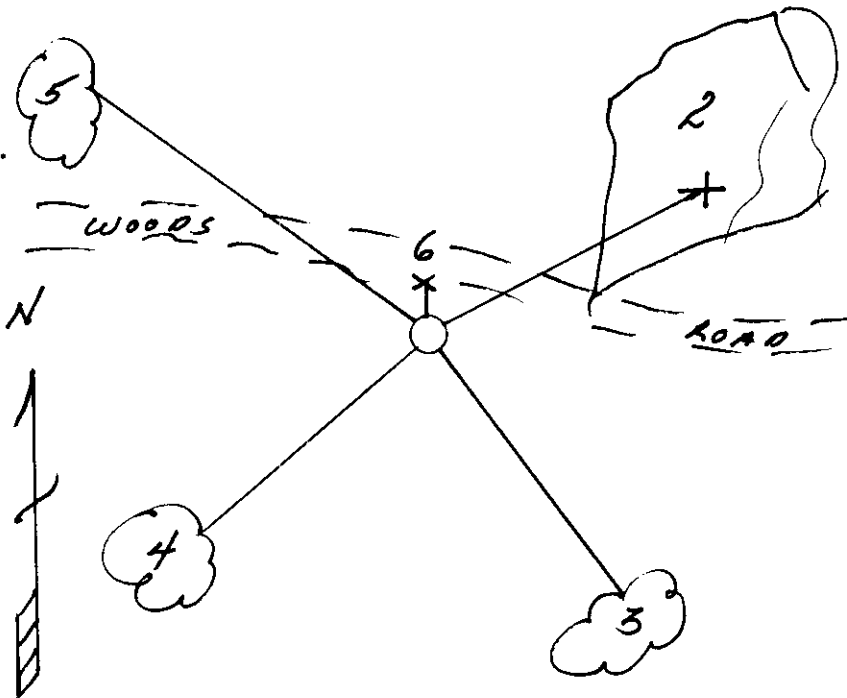

(i) I, Milo E. Stefan
(type or print name) certify that the corner location on this record was determined by me or under my direction and control and that this U.S. Public Land Survey Monument Record is correct and complete to the best of my knowledge and belief.



Milo E. Stefan
Signature

November 28, 1994
Date

Index No. I-13

3706162000