

U.S. PUBLIC LAND SURVEY MONUMENT RECORD

Note: This form is intended and designed to fulfill all requirements of Wisconsin Administrative Code, Chapter A-E 7.08 U.S. Public Land Survey Monument Record (3)(a)(b)(c)(d)(e)(f)(g)(h)(i). An additional sheet may be added if necessary to conform with said requirements.

(a) CORNER LOCATION:


E. Meander corner of Sec. 29
 Township 37 North
 Range 6 East
 Town/~~City/Town~~ Cassian
 County of Oneida

State Plane Coordinates

X _____

Y _____

Datum Base _____

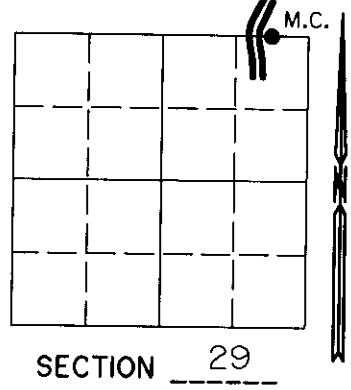


(b)(f)(g)(h) Description of monument found at this corner and if it was accepted, state all evidence (material, testimonial, occupational, plats, records, other monuments) used as a basis for establishing location. If not accepted or if nothing was found, state evidence used as basis for establishing location. If reestablished through lost corner proportionate methods, indicate all monuments, distances and directions used to establish. Indicate type of monument and sign post found or set.

July, 1863 - Joseph H. Jenkins, Deputy Surveyor, ran west on corrected line and at 10.85 chains set Meander Post, Witnessed by two bearing trees: an 8" fir, N32°E, 211ks and an 8" White Ash, S7°W 171ks.

February, 1996 - James D. Rein, Registered Land Surveyor No. S-1234, found no evidence of original corner post and bearing trees. Corner position was established by placing a capped aluminum monument on line between the northeast corner of Section 29, and the North Quarter Corner of Section 29 near the easterly bank of the Tomahawk River. Note a 1" dia. iron pipe set by Owens-Illinois as an approximate Meander Corner bears S35°27'16"W 106.67'.

(c)(d)(e) Plan view of corner with ties to at least 4 witness monuments. If in disagreement with previously established corner, show the distance between the two corners and also indicate the ties to the disputed corner.

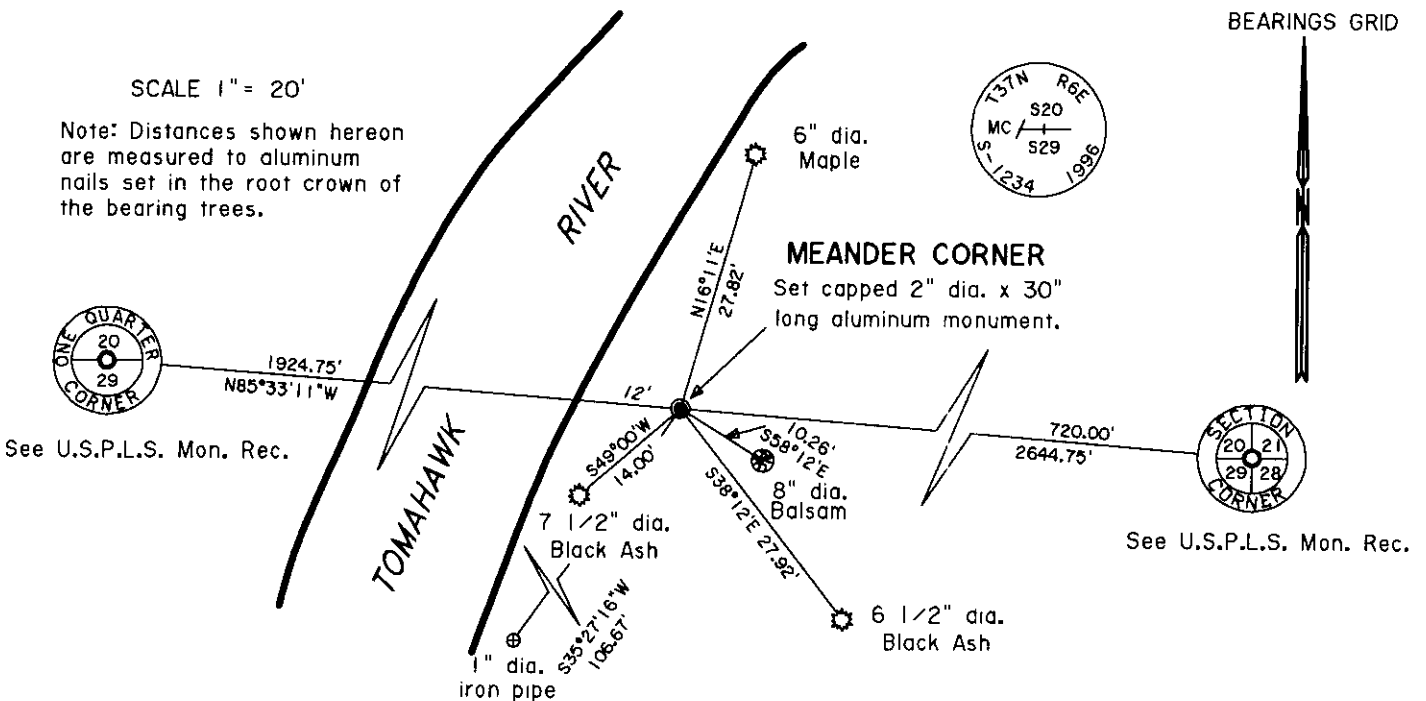

SCALE 1" = 20'


Note: Distances shown hereon are measured to aluminum nails set in the root crown of the bearing trees.

See U.S.P.L.S. Mon. Rec.

See U.S.P.L.S. Mon. Rec.

(i) I, James D. Rein, Registered Land Surveyor No. 1234, hereby certify that the corner location on this record was determined by me or under my direction and control and that this U.S. Public Land Survey Monument Record is correct and complete to the best of my knowledge and belief.

James D. Rein
 Signature _____ Date 3/27/96

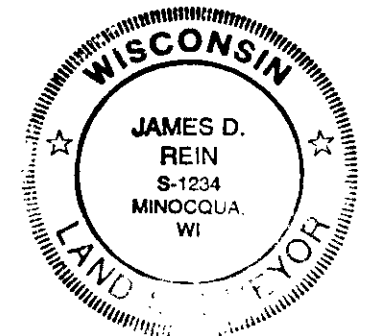

INDEX NO. R 8-9


3706200005

U.S. PUBLIC LAND SURVEY MONUMENT RECORD

Note: This form is intended and designed to fulfill all requirements of Wisconsin Administrative Code, Chapter A-E 7.08 U.S. Public Land Survey Monument Record (3)(a-i).

(a) CORNER LOCATION
 Meander Cor. of Secs. 20 & 29
 Township 37 North
 Range 6 East of the 4th P.M.
 Town of Cassian
 County of Oneida

WISCRS - Oneida County
 N: 177,889.50 USft
 E: 175,357.96 USft
 Datum: NAD 83(2011)
 GNSS Method: RTN - Direct
 GNSS Control: WISCORS VRS

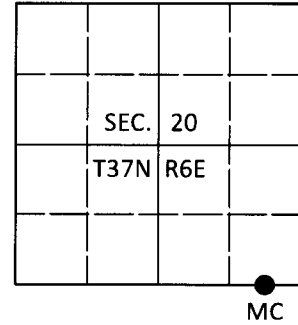

(b) HISTORY OF ORIGINAL CORNER ESTABLISHMENT

Original Surveyor: _____ Original Accessories: _____
 Date of Survey Commenced: _____ See previous monument record(s)
 Completed: _____

(b)(f)(g)(h) Description of monument found at this corner and if it was accepted, state all evidence (material, testimonial, occupational, plats, records, other monuments) used as a basis for accepting. If not accepted or if nothing was found, state evidence used as basis for establishing location. If re-established through lost corner proportionate methods, indicate all monuments, distances and directions used to establish. Indicate type of monument and sign post found or set.

This is a perpetuation of the following monument record(s) that comprise a complete history of the corner:

Mar. 27, 1996: USPLS Monument Record No. 3706200005 by James D. Rein, PLS

May 7, 2020: I found and accepted the record monument, a 2.4" diam. aluminum pipe with a 3.3" diam. Oneida Co. aluminum cap projecting 3" above the ground surface. The record ash bearing tree at S49°W is standing dead. The record 1" diam. iron pipe was found but not remeasured. I found or established accessories as shown below. I found a white vinyl sign post bearing Northwest, 0.5 ft.


The coordinate value shown has been verified by at least one of the following methods: 1) comparison to a previously GPS determined published value; 2) the value is the average of two or more GPS observations at a markedly different time; 3) one or more distances were measured back to the GPS observed corner from temporary GPS observed offset locations.

REGISTER OF DEEDS OFFICE
 ONEIDA COUNTY
 FILED

JUN 26 2020

KYLE J. FRANSON
 REGISTER OF DEEDS

(c)(d)(e) Plan view of corner with ties to at least 4 witness monuments. If in disagreement with previously established corner, show the distances between the two corners and also indicate the ties to the disputed.

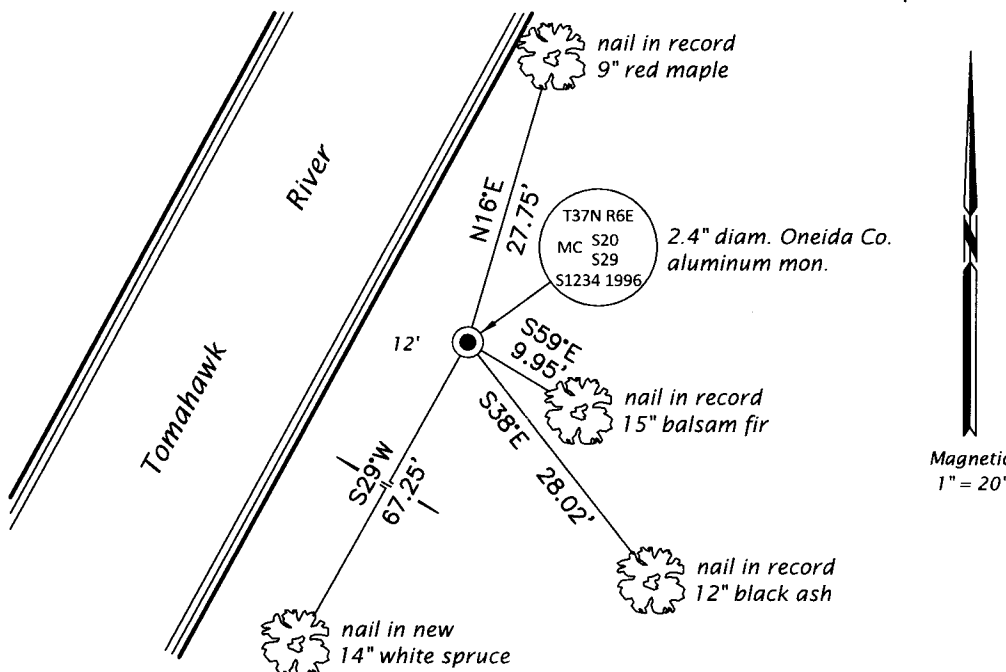

(i) I, Jeffrey W. Austin, Professional Land Surveyor No. S-1885, hereby certify that the corner location on this record was determined by me or under my direction and control and that this U.S. Public Land Survey Monument Record is correct and complete to the best of my knowledge and belief.


 Signature

JUN 5, 2020
 Date