# U.S. PUBLIC LAND SURVEY MONUMENT RECORD

Note: This form is intended and designed to fulfill all requirements of Wisconsin Administrative Code, Chapter A-E 7.08 U.S Public Land Survey Monument Record (3) (a) (b) (c) (d) (e) (f) (g) (h) (i). An additional sheet may be added if necessary to conform with said requirements.

(a) Corner location: Township 37 North

Range 6 East ~~West~~

Town/~~City/Village~~ CASSIAN

County ONEIDA

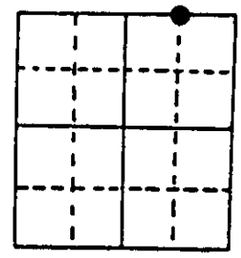

Section 36

(b) (f) (g) (h) Description of monument found at this corner and if it was accepted, state all evidence (material, testimonial, occupational, plats, records, other monuments) used as a basis for accepting. If not accepted or if nothing was found, state evidence used as basis for establishing location. If reestablished through lost corner proportionate methods, indicate all monuments, distances and directions used to establish. Indicate type of monument found or set and sign post.

(c) (d) (e) Plan view of corner with ties to at least 4 witness monuments. If in disagreement with previously established corner, show the distances between the two corners and also indicate the ties to the disputed corner.

THIS RESTORATION WAS PERFORMED TO PROTECT AN EXISTING MONUMENT IN ADVANCE OF ROAD CONSTRUCTION. IT IS RECOMMENDED THAT THIS MONUMENT BE EVALUATED PRIOR TO USING.

1) SET 1" IRON PIPE, N54°E 66.68'
2) SET NAIL IN 12" W. PINE, S59E 65.49'
3) SET 1" IRON PIPE, S54°W 72.92'
4) SET NAIL IN 8" W. PINE, N47°W 75.05'
5) FOUND 2" IRON PIPE

BEARINGS MAGNETIC TAKEN WITH HANDHELD COMPASS.

NO SCALE

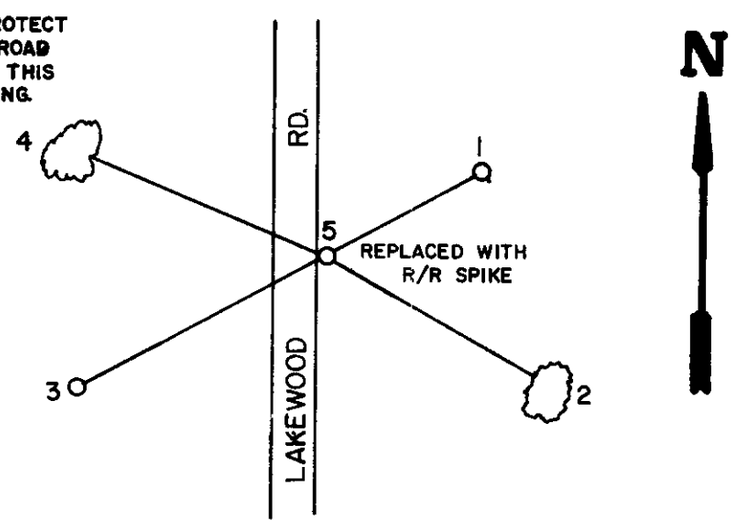


(i) I, WILLIAM E. BANDOW (type or print name) certify that the corner location on this record was determined by me or under my direction and control and that this U.S. Public Land Survey Monument Record is correct and complete to the best of my knowledge and belief.

William E. Bandow 6-24-98

Signature Date

WISCONSIN WILLIAM E. BANDOW S-1182 RHINELANDER, WI LAND SURVEYOR

Stamp

Index No. V 24 3706 25 00 10