

CERTIFIED LAND CORNER RESTORATION

State of Wisconsin }  
County of Oneida } ss.

I John H. Fisher, do hereby certify that on the 25 day of May, 19 81, I found evidence of the north one quarter corner of Section 34 Township 37N Range 6E, Fourth Principal Meridian, as described hereon; and that from this evidence I established a new monument and accessories as described hereon to perpetuate the original location of this corner:

Description of original monument and accessories and subsequent restorations:

The original Gov't. Survey was performed by Joseph H. Jenkins, Deputy Surveyor in June 29, 1863.

Set wood post  
10' Blk. Pine N6°E, 50 links  
10" Blk. Pine N61°E, 1.00 Links

Description of corner evidence found:

Old square post (down) found hole  
0-1 metal tag in 8" Jack Pine (dead) S55°E, 3.4 feet

Description of monument and accessories I established to perpetuate the location of this corner:


Set Oneida County 2" aluminium pipe with stamped aluminium cap.

Set Witness:

6" Spruce S38°W, 95.7 feet  
7" White Birch N6°E, 53.7 feet

Found in Place

0-1 metal tag in 8" Jack Pine (dead) S55°E, 3.4 feet

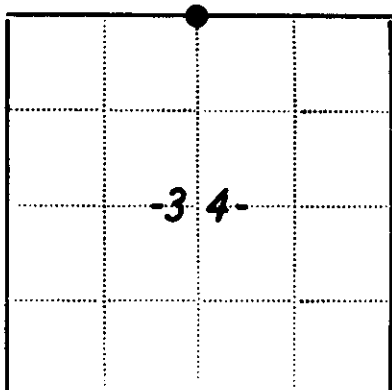

● - Corner monument restored  
□ -

Resident witnesses \_\_\_\_\_

Dated at Minocqua Wisconsin, this 16<sup>th</sup> day of June 19 81.


Signature *John H. Fisher* Registered Land Surveyor  
(County Surveyor, Registered Land Surveyor, or other duly authorized official)

Surveyors Registration No. S-836

Office of REGISTER OF DEEDS County of Oneida

I hereby certify that the within instrument was filed in this office for record on the 17<sup>th</sup> day of September 19 82, and was filed in Book No. \_\_\_\_\_ Page No. \_\_\_\_\_ of County Records.

Signature *Louis Verge Kuehn* Title REGISTER OF DEEDS

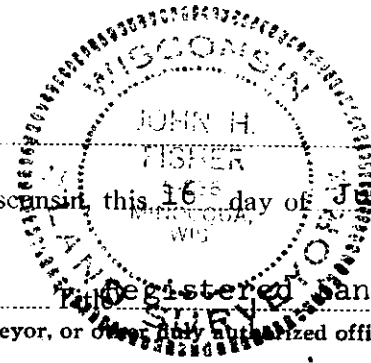

V-15

Township \_\_\_\_\_, Range \_\_\_\_\_, Section \_\_\_\_\_, Index No. \_\_\_\_\_, Page No. \_\_\_\_\_