U.S. PUBLIC LAND SURVEY MONUMENT RECORD

Note: This form is intended and designed to fulfill all requirements of Wisconsin Administrative Code, Chapter A-E 5.02, U.S. Public Land Survey Monument Record (3) (a) (b) (c) (d) (e) (f) (g) (h) (i). An additional sheet may be added if necessary to conform with said requirements.

(a) Corner location: Township 37 North

Range 6 East/~~West~~ =

Town/~~City/Village~~ Cassian

County Oneida

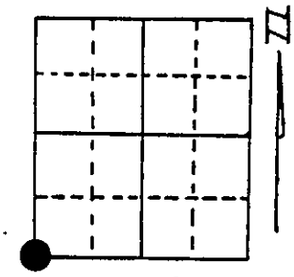

Section 28

(b) (f) (g) (h) Description of monument found at this corner and if it was accepted, state all evidence (material, testimonial, occupational, plats, records, other monuments) used as a basis for accepting. If not accepted or if nothing was found, state evidence used as basis for establishing location. If reestablished through lost corner proportionate methods, indicate all monuments, distances and directions used to establish.

Original survey by Joseph H. Jenkins in 1863.
Wood post set:

Elk Pine	10"	N47°W	10 lks
Elk Pine	8"	N39°E	22 lks

Accepted found 1" iron pipe, piece of old square post and 4"x4" square scribed post (G.I)

Red Pine	Stump	N68°E	3.8 feet
White Pine	10"	N68°W	19.2 feet
Red Pine	20"	N48°E	65.2 feet

Replaced 1" iron pipe with Oneida County 2" diameter 30" long aluminum pipe, with a 3" diameter aluminum tablet stamped to identify corner.

(c) (d) (e) Plan view of corner with ties to at least 4 witness monuments. If in disagreement with previously established corner, show the distances between the two corners and also indicate the ties to the disputed corner.

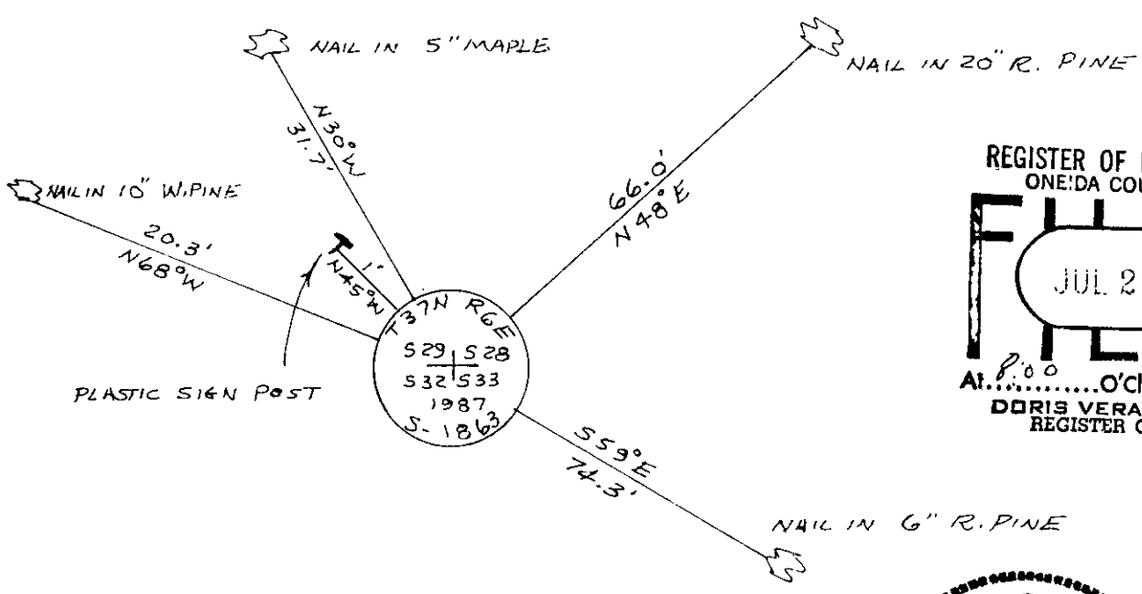

REGISTER OF DEEDS OFFICE
ONEIDA COUNTY, WIS.
FILED
JUL 23 1987
At 8:00 O'Clock M
DORIS VERAGE KUEHN
REGISTER OF DEEDS

(i) I, Dennis B. Roberts
(type or print name) certify that the corner location on this record was determined by me or under my direction and control and that this U.S. Public Land Survey Monument Record is correct and complete to the best of my knowledge and belief.

Dennis B. Roberts 7/9/87
Signature Date

WISCONSIN DENNIS B. ROBERTS S-1863 HARSHAW WIS LAND SURVEYOR

Index No. V-9

3706290000