

# U.S. PUBLIC LAND SURVEY MONUMENT RECORD


**Note:** This form is intended and designed to fulfill all requirements of Wisconsin Administrative Code, Chapter A-E 7.08 U.S. Public Land Survey Monument Record (3) (a) (b) (c) (d) (e) (f) (g) (h) (i). An additional sheet may be added if necessary to conform with said requirements.

(a) Corner location: Township 37 North

Range 6 East/West

Town/City/Village Cassian

County Oneida

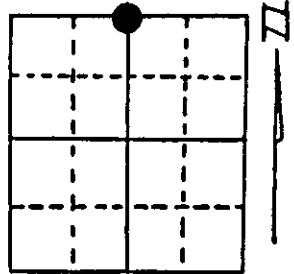

Section 32

(b) (f) (g) (h) Description of monument found at this corner and if it was accepted, state all evidence (material, testimonial, occupational, plats, records, other monuments) used as a basis for accepting. If not accepted or if nothing was found, state evidence used as basis for establishing location. If reestablished through lost corner proportionate methods, indicate all monuments, distances and directions used to establish. Indicate type of monument found or set and sign post.

6/3/1863 - Joseph H. Jenkins established this corner. He set a wood post with one BT - no others near: 8" Black Pine, S39°E, 63 Links (41.58')


9/1994 - Alvin Barden pointed this corner out to me. He stated this iron pipe has been here since the 1920's at which time his mother's (Mrs. Lloyd Barden) folks purchased this nearby land.

10/5/1994 - Milo E. Stefan dug out the iron pipe (a 1 1/4" well point) and replaced it with a 2" x 36" aluminum monument, 8" below road surface (gravel), made new BTs and set plastic sign post.

(c) (d) (e) Plan view of corner with ties to at least 4 witness monuments. If in disagreement with previously established corner, show the distances between the two corners and also indicate the ties to the disputed corner.

- 1) 2" x 36" Aluminum Monument.
- 2) 6" Red Pine, N64°E, 46.45'.
- 3) 6" Red Pine, S50°E, 52.84'.
- 4) 6" Red Pine, S54°W, 50.10'.
- 5) 8" Jack Pine, N53°W, 81.64'.
- 6) Plastic Sign Post, East, 30.00'

Distances to nail in side of BTs.  
Stump blaze scribed "BT"

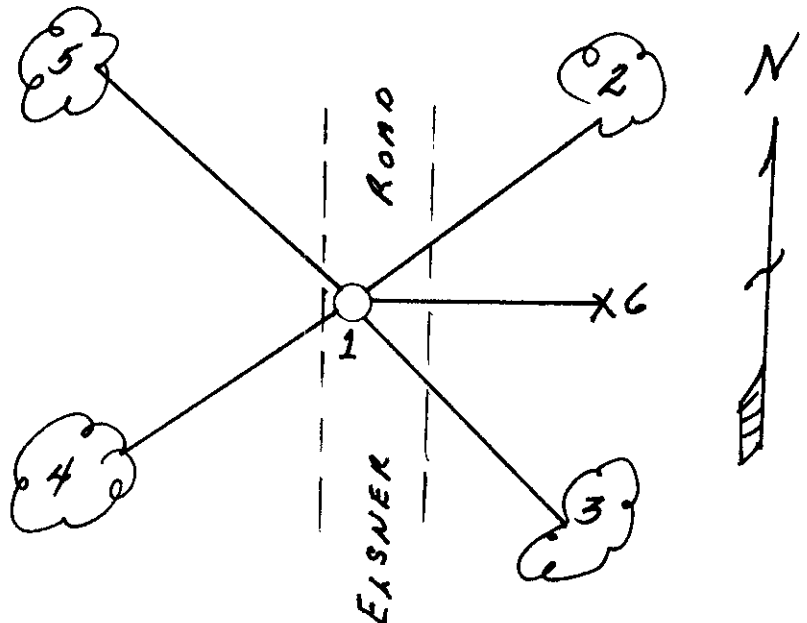

(i) I, Milo E. Stefan  
(type or print name) certify that the corner location on this record was determined by me or under my direction and control and that this U.S. Public Land Survey Monument Record is correct and complete to the best of my knowledge and belief.

Milo E. Stefan  
Signature

10/9/94  
Date



Index No. V-7

Stamp 3706290020