

CERTIFIED LAND CORNER RESTORATION

State of Wisconsin }
County of Oneida } ss.

I James M. Marquardt, do hereby certify that on the 12 day of September, 1979, I found evidence of the East one quarter corner of Section 33 Township 37N Range 6E, Fourth Principal Meridian, as described hereon; and that from this evidence I established a new monument and accessories as described hereon to perpetuate the original location of this corner:


Description of original monument and accessories and subsequent restorations:

The original Gov't. Survey was performed by Jos. H. Jenkins Deputy Surveyor in September 1862.

- 12" Yellow Pine N85°E, 21 (13.86 feet)
12" Yellow Pine N83°W, 40 (26.40 feet)

Description of corner evidence found:

Found 1-1/4" iron pipe 6" below flush

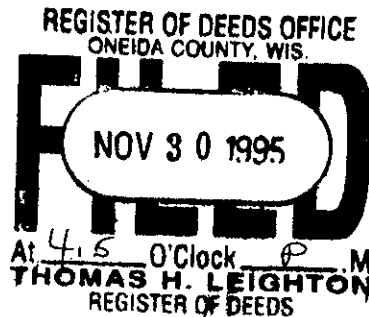


Description of monument and accessories I established to perpetuate the location of this corner:

Oneida County Berntsen Mon-ment

- 8" Jack Pine N72°W, 39.4 feet
8" Jack Pine N 4°W, 36.0 feet
6" Jack Pine N68°E, 12.2 feet

This is a copy of a copy. The original cannot be located. This is being filed for informational purposes. m9r 12/1/95

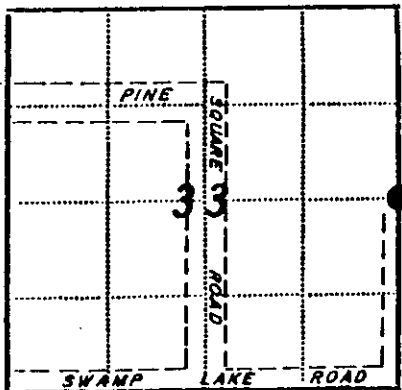

Resident witnesses None

Dated at Minocqua Wisconsin, this 11th day of October 1979

Signature James M. Marquardt Title Registered Land Surveyor (County Surveyor, Registered Land Surveyor, or other duly authorized official)

Surveyors Registration No. S-1405

Office of County of

I hereby certify that the within instrument was filed in this office for record on the day of 19, and was filed in Book No. Page No. of County Records.

Signature Title

Township Range Section Index No. Page No.