


U.S. PUBLIC LAND SURVEY MONUMENT RECORD

Note: This form is intended and designed to fulfill all requirements of Wisconsin Administrative Code, Chapter A-E 5.02, U.S. Public Land Survey Monument Record (3) (a) (b) (c) (d) (e) (f) (g) (h) (i). An additional sheet may be added if necessary to conform with said requirements.

(a) Corner location: Township 37 North
 Range 6 East/West ~~XXXXX~~

Town/City/Village ~~XXXXXXXX~~ Cassian
 County Oneida

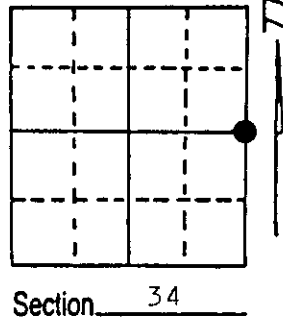


(b) (f) (g) (h) Description of monument found at this corner and if it was accepted, state all evidence (material, testimonial, occupational, plats, records, other monuments) used as a basis for accepting. If not accepted or if nothing was found, state evidence used as basis for establishing location. If reestablished through lost corner proportionate methods, indicate all monuments, distances and directions used to establish.

The original Government Survey was performed by Joseph H. Jenkins in June & July, 1863. A wood post was set: Aspen 10 N27W, 8 lks.; no other tree near.

After extensive traverse work a search was made at the proportionate location and also at the location of the intersection of the East-West one quarter line of section 35 and the section line. No marks of the original or any other surveyor were found. I therefore established the corner at the intersection of the section line and the one quarter line to agree with work surveyed using the existing center of section 35. I set: Aluminum pipe, 30' long, 2 1/2' dia., with aluminum cap stamped as shown below. I established the following witnesses: W. Birch 10' N88E, 42.12', W. Pine 16" N22E, 25.46', N. Pine 16" S14E, 29.10', N. Pine 20' S48W, 22.65', set plastic survey marker sign N45E, 1.0'.

(c) (d) (e) Plan view of corner with ties to at least 4 witness monuments. If in disagreement with previously established corner, show the distances between the two corners and also indicate the ties to the disputed corner.

NE cor 34: N1 01'13"W, 2658.59'
 C 1/4 sec 35: S88 50'36"E, 2609.86'
 SE cor 34: S1 01'13"E, 2763.12'

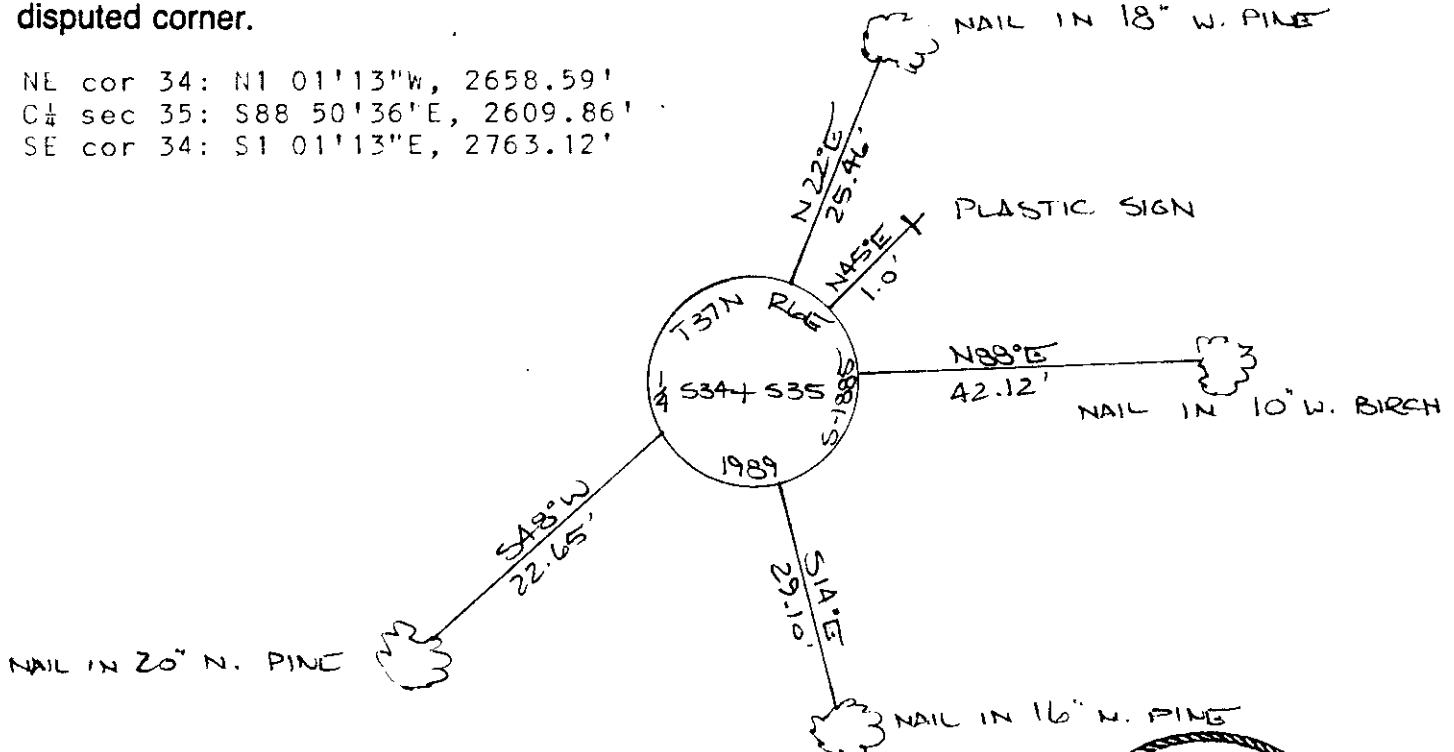

(i) I, JEFFREY W. AUSTIN S-1885
 (type or print name) certify that the corner location on this record was determined by me or under my direction and control and that this U.S. Public Land Survey Monument Record is correct and complete to the best of my knowledge and belief.



Jeffrey W. Austin Signature FEBRUARY 1, 1989 Date

Index No. X-17

3706342000