


# U.S. PUBLIC LAND SURVEY MONUMENT RECORD

Note: This form is intended and designed to fulfill all requirements of Wisconsin Administrative Code, Chapter A-E 7.08 U.S. Public Land Survey Monument Record (3) (a) (b) (c) (d) (e) (f) (g) (h) (i). An additional sheet may be added if necessary to conform with said requirements.

(a) Corner location: Township 37 North  
 Range 7 East/West

Town/City/Village Lake Tomahawk  
 County Oneida

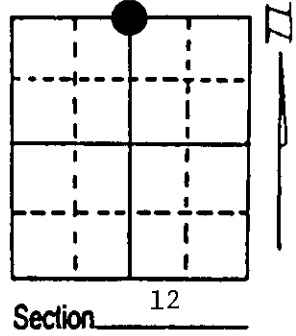


(b) (f) (g) (h) Description of monument found at this corner and if it was accepted, state all evidence (material, testimonial, occupational, plats, records, other monuments) used as a basis for accepting. If not accepted or if nothing was found, state evidence used as basis for establishing location. If reestablished through lost corner proportionate methods, indicate all monuments, distances and directions used to establish. Indicate type of monument found or set and sign post.

- Nov. 1862 - Joseph H. Jenkins established this corner, set a wood post with BTs:  
 10" Aspen, N9°E, 15 Links (9.9') 8" Aspen, S78°W, 40 Links (26.40')
- 4/3/1939 - Vern Maine restored this corner by Lost Methods. He set a Cedar Stake with two BTs: 12" White Pine, N85°E, 108.8 Links (71.81')  
 8" Oak, N73°W, 44.6 Links (29.44')
- 6/5/1996 - Milo E. Stefan found fallen scribed Cedar Post and the hole it fell from. Also, found scribed 18" White Pine Stump at S85°E at 72.8' (recently cut down). Maine's Oak BT (dead and fallen - chopped out stump blaze and found scribing overgrown) at proper bearing and distance. We set an aluminum monument with four new references and plastic sign post.

(c) (d) (e) Plan view of corner with ties to at least 4 witness monuments. If in disagreement with previously established corner, show the distances between the two corners and also indicate the ties to the disputed corner.

- 1) 2" x 30" Aluminum Monument
- 2) 6' x 4' x 12" Pink Granite Boulder, N28°E, 19.59'
- 3) 5' x 4' x 3' Gray Granite Boulder, S84°E, 45.21'
- 4) 3' x 3' x 2' Gray Granite Boulder, S12°E, 23.63'
- 5) 2' x 2' x 12" Gray Granite Boulder, S34°W, 14.00'
- 6) 18" W. Pine Stump, S85°E, 72.8'
- 7) 12" Fallen Oak Snag, N73°W, 29.4'
- 8) Plastic Sign Post, East, .75'

Distances to "X" Chiseled in Boulder.  
 Area clear cut 2 - 3 years ago.

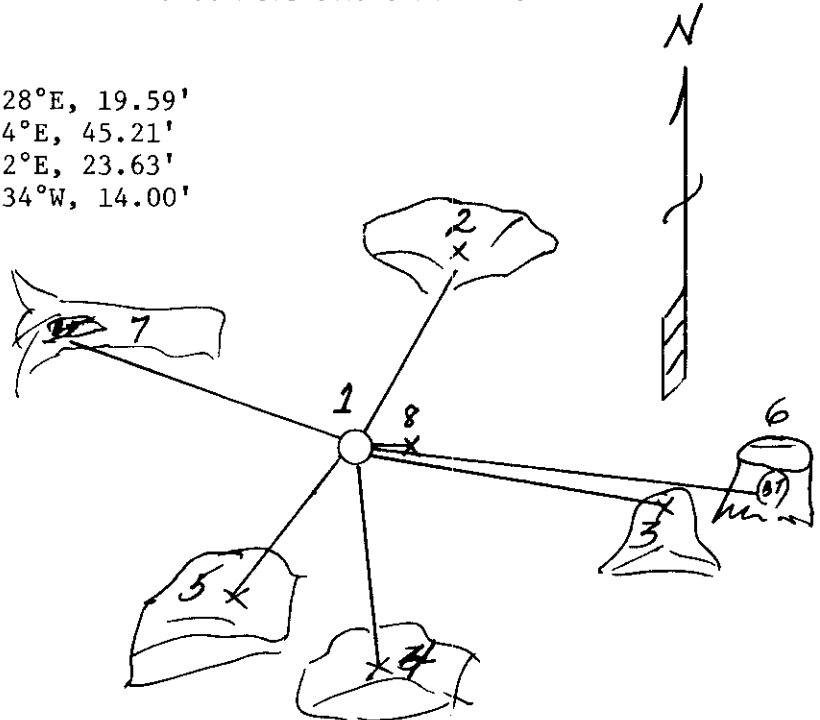

(i) I, Milo E. Stefan  
 (type or print name) certify that the corner location on this record was determined by me or under my direction and control and that this U.S. Public Land Survey Monument Record is correct and complete to the best of my knowledge and belief.

Milo E. Stefan Signature  
 June 18, 1996 Date



3707010020  
 Stamp