


U.S. PUBLIC LAND SURVEY MONUMENT RECORD

Note: This form is intended and designed to fulfill all requirements of Wisconsin Administrative Code, Chapter A-E 7.08 U.S. Public Land Survey Monument Record (3) (a) (b) (c) (d) (e) (f) (g) (h) (i). An additional sheet may be added if necessary to conform with said requirements.

(a) Corner location: Township 37 North
 Range 7 East/West

Town/City/Village Lake Tomahawk
 County Oneida

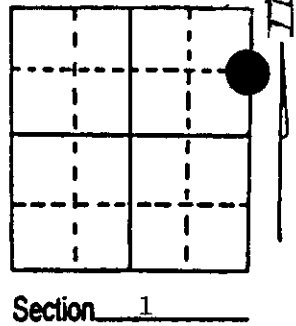

(b) (f) (g) (h) Description of monument found at this corner and if it was accepted, state all evidence (material, testimonial, occupational, plats, records, other monuments) used as a basis for accepting. If not accepted or if nothing was found, state evidence used as basis for establishing location. If reestablished through lost corner proportionate methods, indicate all monuments, distances and directions used to establish. Indicate type of monument found or set and sign post.


9/18/1936 - Vern Maine established this corner and set a 6" x 6" wood post.

6/25/1996 - Milo E. Stefan found Maine's post rotted off and point of post deep in swamp. As this position could easily be lost we set an aluminum monument, took new BTs and placed a plastic sign post.

(c) (d) (e) Plan view of corner with ties to at least 4 witness monuments. If in disagreement with previously established corner, show the distances between the two corners and also indicate the ties to the disputed corner.

- 1) 2" x 30" Aluminum Monument.
- 2) 10" Cedar, N37°E, 32.37'.
- 3) 7" Cedar, S58°E, 36.43'.
- 4) 8" Cedar, S33°W, 16.04'.
- 5) 6" Cedar, S44°W, 18.05'.
- 6) Plastic Sign Post, North, 1.0'.

Distances to nail in side of BTs.
 Stump blazes scribed "BT".
 BT tag placed on face of each BT.

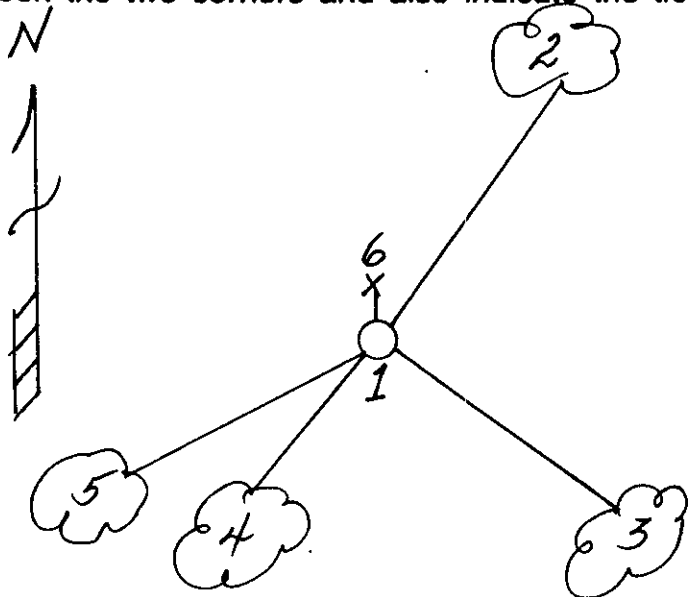

REGISTER OF DEEDS OFFICE
 ONEIDA COUNTY, WIS.
FILED
 SEP - 4 1996
 At 0 O'Clock M
THOMAS H. LEIGHTON
 REGISTER OF DEEDS
 Milo E. Stefan

(i) I, _____
 (type or print name) certify that the corner location on this record was determined by me or under my direction and control and that this U.S. Public Land Survey Monument Record is correct and complete to the best of my knowledge and belief.

Milo E. Stefan August 17, 1996
 Signature Date



370701 3000
 Stamp

Index No. B-25