


U.S. PUBLIC LAND SURVEY MONUMENT RECORD

Note: This form is intended and designed to fulfill all requirements of Wisconsin Administrative Code, Chapter A-E 7.08 U.S. Public Land Survey Monument Record (3) (a) (b) (c) (d) (e) (f) (g) (h) (i). An additional sheet may be added if necessary to conform with said requirements.

(a) Corner location: Township 37 North
 Range 7 East/West

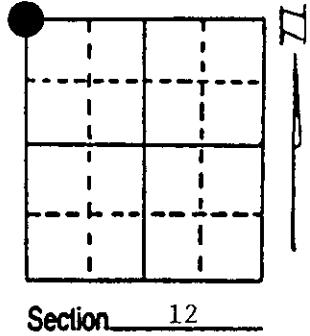

Town/City/Village Lake Tomahawk
 County Oneida

(b) (f) (g) (h) Description of monument found at this corner and if it was accepted, state all evidence (material, testimonial, occupational, plats, records, other monuments) used as a basis for accepting. If not accepted or if nothing was found, state evidence used as basis for establishing location. If reestablished through lost corner proportionate methods, indicate all monuments, distances and directions used to establish. Indicate type of monument found or set and sign post.

Nov. 1863 - Joseph H. Jenkins established this corner/four BTs:
 7" Maple, N14°E, 30 Links (19.80') 14" Aspen, S34°E, 10 Links (6.60')
 9" Aspen, S36°W, 12 Links (7.92') 10" Aspen, N56°W, 50 Links (33.00')


Sept. 24, 1936 - Vern Maine restored corner from remains of original Maple BT,
 N14°E, 30 Links; fence line East and West and two local BTs:
 10" White Pine Stump, North, 49 Links (32.34')
 5" White Pine, S54°W, 34 Links (22.44')
 Maine set a 2" x 60" iron pipe/brass cap/two BTs:
 5" Oak, N57°E, 13 Links (8.58')
 40" Grey Boulder, N78°W, 31 Links (20.46')

5/15/1996 - Milo E. Stefan found Maines monument in good condition with 12" Oak,
 N57°E, 13 Links and Grey Granite Boulder, N78°W, 31 Links. We made new
 BTs and set sign post.

(c) (d) (e) Plan view of corner with ties to at least 4 witness monuments. If in disagreement with previously established corner, show the distances between the two corners and also indicate the ties to the disputed corner.

- 1) 2" x 60" Iron Pipe/Brass Cap
- 2) 12" Red Oak, N73°E, 2.50'
- 3) 6" Red Oak, S2°W, 14.48'
- 4) 4" Red Oak, S50°W, 37.30'
- 5) 13" Red Oak, N68°W, 29.47'
- 6) Plastic Sign Post, North, 1.0'

Distances from nail in side of BTs
 Stump blaze scribed "BT"
 BT tags on face of each BT

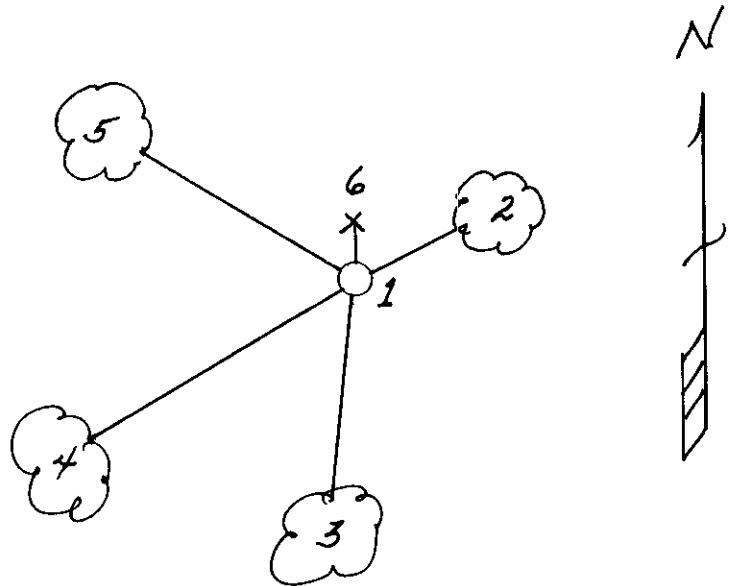

(i) I, Milo E. Stefan
 (type or print name) certify that the corner location on this record was determined by me or under my direction and control and that this U.S. Public Land Survey Monument Record is correct and complete to the best of my knowledge and belief.

Milo E. Stefan
 Signature

June 18, 1996
 Date



3707020000
 Stamp