


# U.S. PUBLIC LAND SURVEY MONUMENT RECORD

Note: This form is intended and designed to fulfill all requirements of Wisconsin Administrative Code, Chapter A-E 7.08 U.S. Public Land Survey Monument Record (3) (a) (b) (c) (d) (e) (f) (g) (h) (i). An additional sheet may be added if necessary to conform with said requirements.

(a) Corner location: Township 37 North  
Range 7 East/West

Town/City/Village Lake Tomahawk  
County Oneida

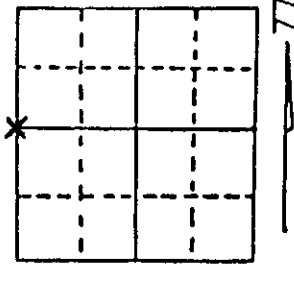

Section 2

(b) (f) (g) (h) Description of monument found at this corner and if it was accepted, state all evidence (material, testimonial, occupational, plats, records, other monuments) used as a basis for accepting. If not accepted or if nothing was found, state evidence used as basis for establishing location. If re-established through lost corner proportionate methods, indicate all monuments, distances and directions used to establish. Indicate type of monument found or set and sign post.


Nov. 1862 - Joseph H. Jenkins established this corner at 41.93 chains south of the Township Line and set a wood post:  
8" Birch, S29°E, 75 links                      8" Y. Pine, N10°W, 300 links

6/20/1975 - Stuart Foltz found post and used this for corner to plat for NE Quarter to Section 3 and made BTs:  
6" White Birch, N69°E, 33.0'                      10" White Birch, S60°E, 36.3'

2/14/1989 - Milo E. Stefan found 4" x 4" Oak Post with 1 1/4" x 60" iron pipe along side - both Birch by Foltz okay. I accept this post and iron pipe as the best available evidence and restore the corner by placement of a monument and I made new BTs and set a plastic sign post.

(c) (d) (e) Plan view of corner with ties to at least 4 witness monuments. If in disagreement with previously established corner, show the distances between the two corners and also indicate the ties to the disputed corner.

- 1. 1/2" x 72" Re-bar/Aluminum Cap Inside  
1 1/4" x 60" Iron Pipe.
  - 2. 6" Red Oak, N61°E, 30.89'
  - 3. 6" White Birch, N69°E, 33.0'
  - 4. 8" White Birch, S60°E, 36.3'
  - \*5. 10" White Pine, N73°W, 210.05'
  - 6. Plastic Sign Post, South, 1.2'
- \* Tree not scribed.

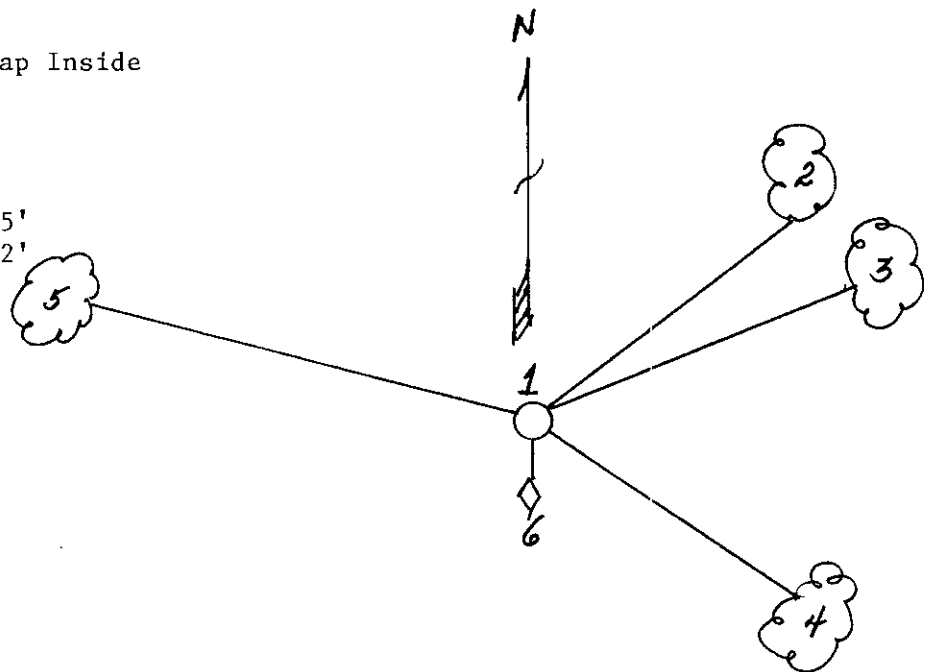

(i) I, Milo E. Stefan  
(type or print name) certify that the corner location on this record was determined by me or under my direction and control and that this U.S. Public Land Survey Monument Record is correct and complete to the best of my knowledge and belief.

Milo E. Stefan                      2/16/89  
Signature                      Date



Index No. C-17

3707032000