


U.S. PUBLIC LAND SURVEY MONUMENT RECORD

Note: This form is intended and designed to fulfill all requirements of Wisconsin Administrative Code, Chapter A-E 7.08 U.S. Public Land Survey Monument Record (3) (a) (b) (c) (d) (e) (f) (g) (h) (i). An additional sheet may be added if necessary to conform with said requirements.

(a) Corner location: Township 37 North
 Range 7 East/West

Town/City/Village Cassian

County Oneida

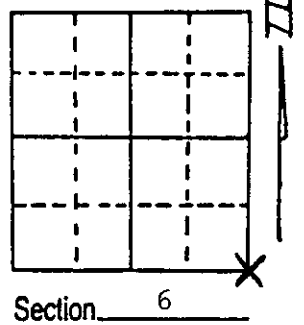

(b) (f) (g) (h) Description of monument found at this corner and if it was accepted, state all evidence (material, testimonial, occupational, plats, records, other monuments) used as a basis for accepting. If not accepted or if nothing was found, state evidence used as basis for establishing location. If reestablished through lost corner proportionate methods, indicate all monuments, distances and directions used to establish.

November 1862, Joseph H. Jenkins set post for section corner, 5, 6, 7 and 8:

- 10" Y. Pine, N87°E, 8 Links (5.28')
- 10" Y. Pine, S24°E, 22 Links (14.52')
- 10" Y. Pine, S84°W, 16 Links (10.56')
- 10" Y. Pine, N44°W, 14 Links (9.24')

May 11, 1988 Milo E. Stefan found: 1 1/2" x 24" iron pipe with 3/4" pipe inside. Owen-Illinois set Cedar post along side iron pipes, 3 - 5 years ago. Remains of NW and SW original Bts in places as very decayed stumps. Distances to shore of Simons Lake fits well.

Local BTs - all overgrown 30 - 50 years old. (BT blazes only)


- 10" Red Pine, East, 11.88 Feet
- 20" White Pine, S80°W, 15.47 Feet
- 22" Red Pine, N2°W, 9.51 Feet

I replaced iron pipes with county monument, made new BT and set plastic post.

(c) (d) (e) Plan view of corner with ties to at least 4 witness monuments. If in disagreement with previously established corner, show the distances between the two corners and also indicate the ties to the disputed corner.

1. Oneida County aluminum monument in mound of stone and earth.
2. 10" Red Pine, East, 11.88 Feet.
3. 12" Red Pine, S37°E, 21.88 Feet. (T37NR7E S8 BT)
4. 20" White Pine, S80°W, 15.47 Feet.
5. 22" Red Pine, N2°W, 9.51 Feet.
6. O-I's Cedar post, SW, .5 Feet.
7. Plastic sign post, SE, 1.0 Feet.

Distances to nail in side of trees.

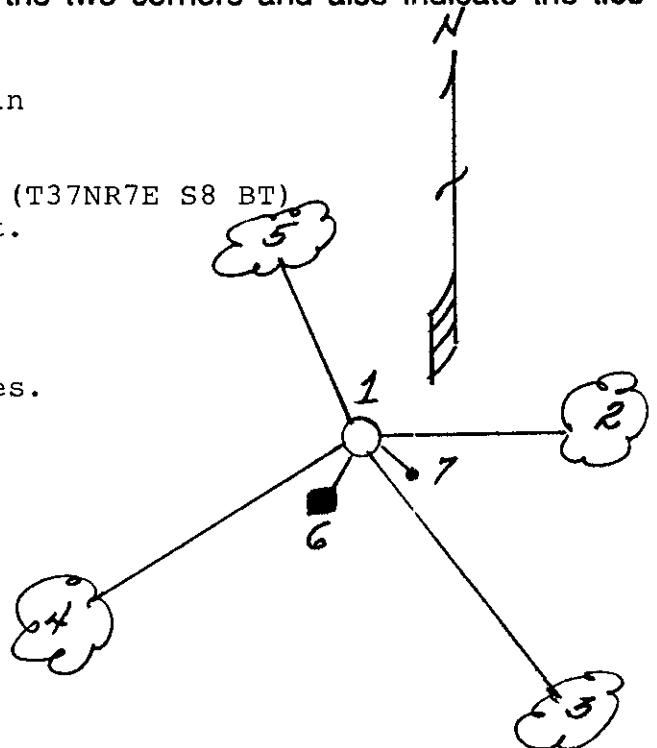

(i) I, Milo E. Stefan
 (type or print name) certify that the corner location on this record was determined by me or under my direction and control and that this U.S. Public Land Survey Monument Record is correct and complete to the best of my knowledge and belief.

Milo E. Stefan
 Signature

May 12, 1988
 Date



Index No. E-5

3707060000