


# U.S. PUBLIC LAND SURVEY MONUMENT RECORD

Note: This form is intended and designed to fulfill all requirements of Wisconsin Administrative Code, Chapter A-E 7.08 U.S. Public Land Survey Monument Record (3) (a) (b) (c) (d) (e) (f) (g) (h) (i). An additional sheet may be added if necessary to conform with said requirements.

(a) Corner location: Township 37 North  
 Range 7 East/West

Town/City/Village Cassian

County Oneida

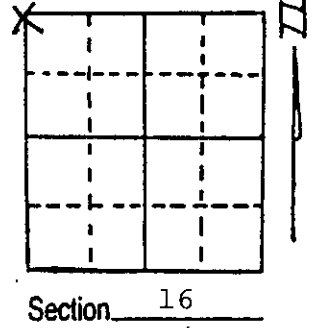


(b) (f) (g) (h) Description of monument found at this corner and if it was accepted, state all evidence (material, testimonial, occupational, plats, records, other monuments) used as a basis for accepting. If not accepted or if nothing was found, state evidence used as basis for establishing location. If reestablished through lost corner proportionate methods, indicate all monuments, distances and directions used to establish.

November 1862, Joseph H. Jenkins set post to sections 8, 9, 16 and 17:  
 6" Spruce, N48°E, 20 links (13.20 feet)  
 6" Spruce, S35°E, 19 links (12.54 feet)  
 6" Spruce, S44°W, 48 links (31.68 feet)  
 7" Spruce, N57°W, 60 links (39.60 feet)  
 March 24, 1968 Wincentzen found 6" x 6" post with original BT 7" Spruce N57°W, 60 links and made two new BTs:  
 6" Spruce, N12°W, 35 links (23.10 feet)  
 5" Spruce, S88°E, 21 links (13.86 feet)  
 May 24, 1988 Milo E. Stefan found scribed post rotted off with post point good and both of Wincentzen BTs broken off.  
 I placed county monument in post hole and made new BTs.

(c) (d) (e) Plan view of corner with ties to at least 4 witness monuments. If in disagreement with previously established corner, show the distances between the two corners and also indicate the ties to the disputed corner.

1. 2" x 36" Oneida County aluminum monument.
2. 6" Black Spruce, N34°E, 17.13 feet (T37N R7E S8 BT)
3. 6" Black Spruce, S73°E, 16.40 feet (T37N R7E S16 BT)
4. 4" Black Spruce, S21°W, 15.98 feet (X BT)
5. 5" Black Spruce, N19°W, 23.73 feet (T37N R7E S9 BT)
6. Plastic sign post, SE, 1.2 feet

(Trees scribed accordingly)  
 Distances to nail in side of trees.

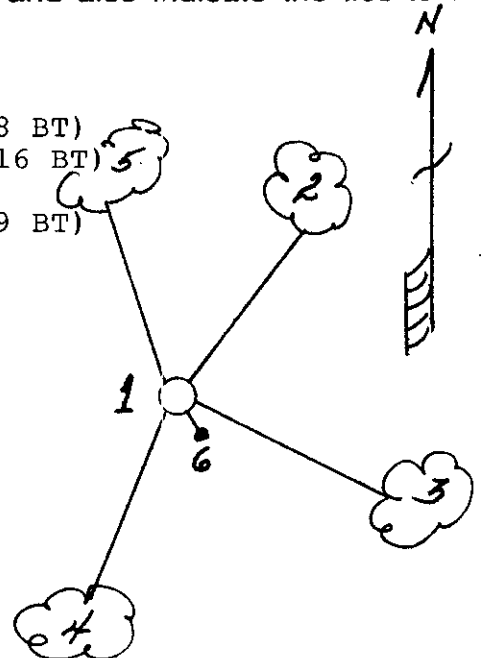

(i) I, Milo E. Stefan  
 (type or print name) certify that the corner location on this record was determined by me or under my direction and control and that this U.S. Public Land Survey Monument Record is correct and complete to the best of my knowledge and belief.

Milo E. Stefan May 24, 1988  
 Signature Date



Index No. J-9

3707080000