

U.S. PUBLIC LAND SURVEY MONUMENT RECORD


Note: This form is intended and designed to fulfill all requirements of Wisconsin Administrative Code, Chapter A-E 5.02, U.S. Public Land Survey Monument Record (3) (a) (b) (c) (d) (e) (f) (g) (h) (i). An additional sheet may be added if necessary to conform with said requirements.

(a) Corner location: Township 37 North

Range 7 East/West

Town/City/Village Cassian

County Oneida

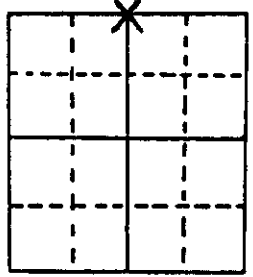

Section 17

(b) (f) (g) (h) Description of monument found at this corner and if it was accepted, state all evidence (material, testimonial, occupational, plats, records, other monuments) used as a basis for accepting. If not accepted or if nothing was found, state evidence used as basis for establishing location. If reestablished through lost corner proportionate methods, indicate all monuments, distances and directions used to establish.

November 1862, Joseph H. Jenkins set 1/4 section post to sections 8/17:
 10" W. Pine, N8°W, 12 links (7.92')
 10" W. Pine, S8°W, 10 links (6.60')

December 6, 1910 D. H. Vaughan found original BT and set new post and BTs:
 7" Aspen, N15°W, 17 1/2 links (11.55')
 8" W. Pine, N66°E, 27 links (17.82')

May 24, 1988 Milo E. Stefan found 1/2" x 24" iron pipe with large spike 2" below road surface with two BTs and location poster post, north 11.5 feet:
 10" Fir, N47°W, 28.63 feet
 8" Red Pine, N27°E, 12.96 feet


Work done by Owens - Illinois in 1980.

I accept this position as the best remaining evidence of the original corner and placed county monument. 6" below road surface with pipe and spike buried alongside.

(c) (d) (e) Plan view of corner with ties to at least 4 witness monuments. If in disagreement with previously established corner, show the distances between the two corners and also indicate the ties to the disputed corner.

1. 2" x 36" Oneida County aluminum monument.
2. 8" Red Pine, N27°E, 12.96 feet.
3. 10" Red Pine, S38°E, 75.04 feet (1/4S BT)
4. 5" White Pine, S54°W, 55.94 feet (X BT)
5. 10" Balsam Fir, N47°W, 28.63 feet
6. Location poster post, north, 11.6 feet.
7. Plastic sign post, north, 11.4 feet.

(Trees scribed accordingly)
 Distances to nail in side of trees.

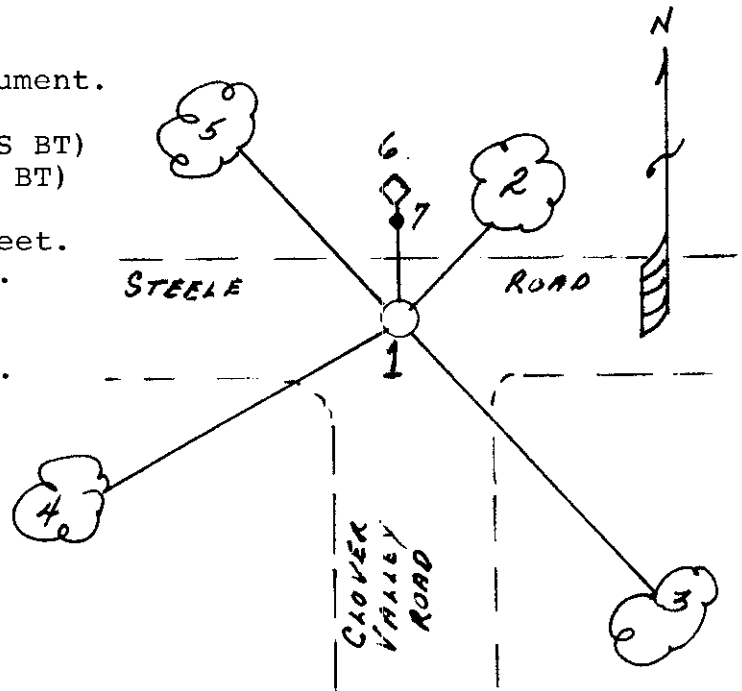

(i) I, Milo E. Stefan
 (type or print name) certify that the corner location on this record was determined by me or under my direction and control and that this U.S. Public Land Survey Monument Record is correct and complete to the best of my knowledge and belief.

Milo E. Stefan
 Signature

May 24, 1988
 Date



3707080020

Index No. J-7