

# U.S. PUBLIC LAND SURVEY MONUMENT RECORD


Note: This form is intended and designed to fulfill all requirements of Wisconsin Administrative Code, Chapter A-E 7.08 U.S. Public Land Survey Monument Record (3) (a) (b) (c) (d) (e) (f) (g) (h) (i). An additional sheet may be added if necessary to conform with said requirements.

(a) Corner location: Township 37 North

Range 7 East/West

Town/City/Village Cassian

County Oneida

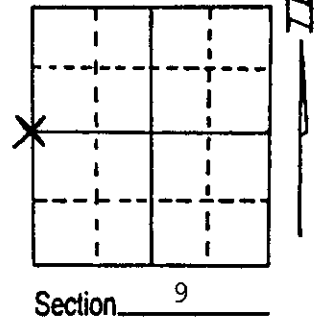

(b) (f) (g) (h) Description of monument found at this corner and if it was accepted, state all evidence (material, testimonial, occupational, plats, records, other monuments) used as a basis for accepting. If not accepted or if nothing was found, state evidence used as basis for establishing location. If reestablished through lost corner proportionate methods, indicate all monuments, distances and directions used to establish.

November 1862, Joseph H. Jenkins set post for 1/4 corner to sections 8 and 9:


- 7" Y. Pine, N34°E, 12 Links (7.92')
- 15" Y. Pine, N29°W, 21 Links (13.86')
- 6/18/57, Marlowe Burgy (S-432) found, large White Pine stump with "OBT" on SE face, and set 2 1/2" galv. iron pipe with B.C:
- 19" W. Pine, S10°W, 61.0' (now dead - 1988)
- 16.6" W. Pine, N27°W, 76.9' (scribed "S8 1/4" in stump blaze).
- 5/12/88, Milo E. Stefan found: 1" x 24" iron pipe with Owens-Illinois Cedar post along side. Hole where Burgy monument was placed bears N27°W, 7.5 Feet.

I agree that the Burgy monument was not set from the original Yellow Pine BT, to the NW. I, therefore, accept the iron pipe and placed the county monument there.

(c) (d) (e) Plan view of corner with ties to at least 4 witness monuments. If in disagreement with previously established corner, show the distances between the two corners and also indicate the ties to the disputed corner.

1. Oneida County aluminum monument.
2. 8" Red Maple, N20°E, 50.59 Feet (1/4S BT).
3. 5" Black Spruce, S49°W, 38.07 Feet (1/4S BT)
4. 6" Tamarack, N73°W, 45.29 Feet (1/4S BT).
5. 26" White Pine, N27°W, 84.39 Feet (S8 1/4).
6. O-I Cedar post, south, 1.0 Feet.
7. Plastic sign post, East, 1.0 Feet.

(Scribed accordingly)  
Distances to nail in side of trees.

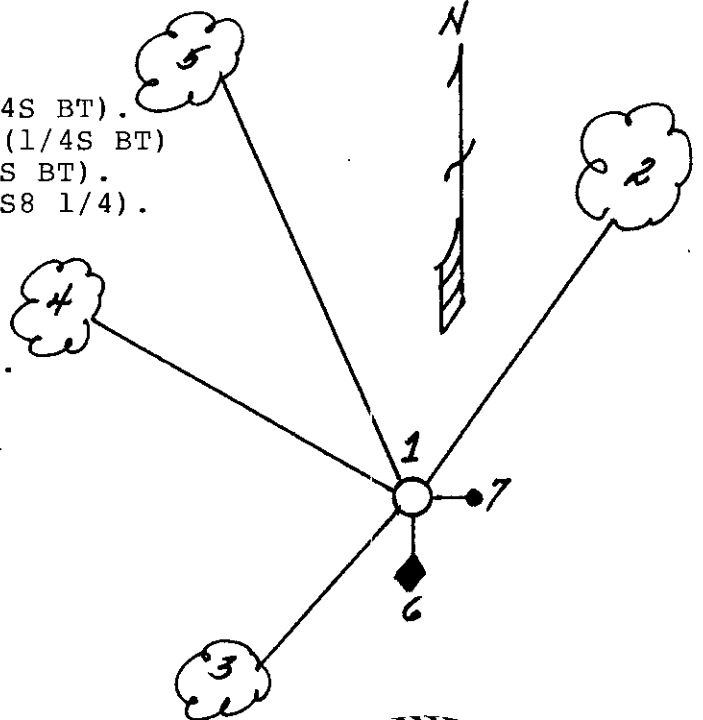

(i) I, Milo E. Stefan  
(type or print name) certify that the corner location on this record was determined by me or under my direction and control and that this U.S. Public Land Survey Monument Record is correct and complete to the best of my knowledge and belief.

Milo E. Stefan May 12, 1988  
Signature Date



Index No. G-9

3707082000