

CERTIFIED LAND CORNER RESTORATION

Index No. J-11



State of Wisconsin

County of Oneida } ss.

I Philip T. Hansen, do hereby certify that on the 6th day of October, 1979, I found evidence of the Quarter corner of Sections 9 and 16 Township 37, North, Range 7 East, Fourth Principal Meridian, as described hereon; and that from this evidence I established a new monument and accessories as described hereon to perpetuate the original location of this corner.

Resident witnesses:

Howard Lovestea

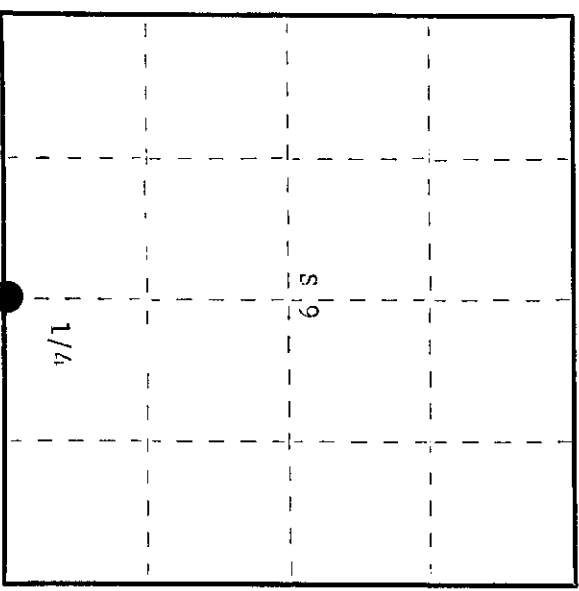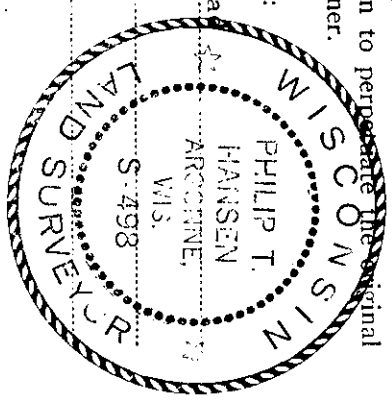

○ = Corner monument restored.

History of original corner establishment:
Original corner established by J.H. Jenkins, Deputy Surveyor, in 1862.
Corner recovered by D.H. Vaughan, County Surveyor, in 1910.
Corner recovered by F. Vincentsen, Registered Land Surveyor. No accessories established.

Description of corner evidence found:
Recovered an old 4" wood post setting beside an old 2" iron pipe projecting 18" above ground. A ring of rocks was recovered around the base.
Recovered White fine 28", S72°E 30.4' blazed with old notch.
White fine stub N34°W 97.7 feet, scribe marks cut off with power saw.
No trace of old W.Fine 10" N5°E 24 links.

Description of monument and accessories I established to perpetuate the original location of this corner.
Replaced iron pipe with 2-1/2" Bernitsen A-1 Federal Monument, stamped:
Reset old iron pipe and wood post beside it.
Monument projects 8" above ground.
Marked NBT - Red Maple 18" N44°W 58.6 feet.

T37N R7E
S 19
1/4
S498

Dated at Rhinelander, Wis., this 5th day of November, 1979

Signature Philip T. Hansen Title Registered Land Surveyor Registration No. S-498
(County Surveyor, Registered Land Surveyor, or other duly authorized official)

Office of Register of Deeds, County of Oneida
Instrument was filed in this office for record on the 3rd day of December, 1979
at 115 o'clock M.

Doris Savage Kuehn
(Register of Deeds)

By: _____ Deputy

370709020