

CERTIFIED LAND CORNER RESTORATION  
U.S. PUBLIC LAND SURVEY MONUMENT RECORD

**FILED**  
MAY 11 1983  
At 4:15 O'Clock P.M.  
DORIS VERAGE KUEHN  
REGISTER OF DEEDS

State of Wisconsin }  
County of Oneida } ss.

I JEROME N. KRAEMER, do hereby certify that on the 15th day of October, 1975, I found evidence of the East Meander Corner corner of Sections 10 and 15 Township 37 North, Range 7 East, Fourth Principal Meridian, as described hereon; and that from this evidence I established a new monument and accessories as described hereon to perpetuate the original location of this corner:

Description of original monument and accessories and subsequent restorations:

Original Government corner, established a wood post in 1862 by Joseph H. Jenkins Government Deputy Surveyor.  
From County survey records: D. H. Vaughn found Allen's post and bearing trees in 1911. From County survey records; V. Maine found Allen's perpetuation of original Government meander corner. Maine set new oak stake and marked new bearing trees:  
Birch 10" S30°E, 15  
Birch 8" N23°E, 25  
Black Oak 5" N28°E, 10-1/2  
White Pine 10" S19°E, .49

Description of corner evidence found:

Found 1-1/4 inch rebar protruding 4 inches above ground level.  
Wood Post with W.C.D. location tag bears East 1 foot.  
Old barbed wire fence runs Easterly.  
Bearing trees found:  
31" White Pine, N20°W, 20.3 feet (Allen)  
13" Oak N28°E, 5.7 feet (Maine)  
16" White Pine stump S20°E, 33.0 feet (Maine)

Description of monument and accessories I established to perpetuate the location of this corner:


July 21, 1981

Established new bearing trees, 1 blazed, scribed and set P.K. Nails in the following trees:  
9" Maple S3°E, 5.57 feet  
10" White Birch S50°E, 14.36 feet  
9" Oak N74°E, 14.53 feet

Corner is 3 feet East of Horsehead Lake.

Compared with all record data & accepted as correct.

*Robert H. Kival*  
Oneida County Surveyor 27 Apr 1983

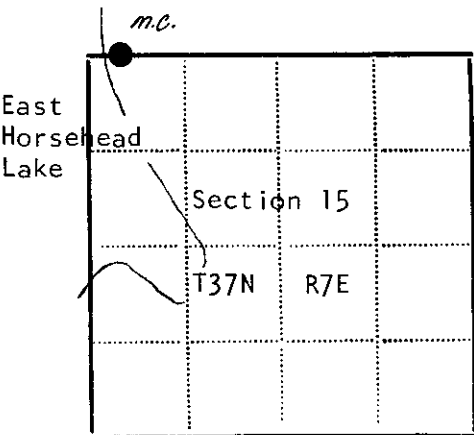

● - Corner monument restored  
□ -

Resident witnesses.....

Dated at Minocqua Wisconsin, this 5th day of January 1983.

Signature *Jerome N. Kraemer* Title Reg. Land Surveyor  
(County Surveyor, Registered Land Surveyor, or other duly authorized official)

Surveyors Registration No. S-1448

Office of..... County of.....

I hereby certify that the within instrument was filed in this office for record on the..... day of..... 19....., and was filed in Book No..... Page No..... of County Records.

Signature..... Title.....

Township 37 North, Range 7 East, Section....., Index No....., Page No.....

3707100038

2-13