U.S. PUBLIC LAND SURVEY MONUMENT RECORD

Note: This form is intended and designed to fulfill all requirements of Wisconsin Administrative Code, Chapter A-E 5.02, U.S Public Land Survey Monument Record (3) (a) (b) (c) (d) (e) (f) (g) (h) (i). An additional sheet may be added if necessary t conform with said requirements.

(a) Corner location: Township 37 North

Range 8 East/~~West~~

Town/~~City/Village~~ Newbold

County Oneida

REGISTER OF DEEDS OFFICE ONEIDA COUNTY, WIS.

At 8:00 O'clock a M

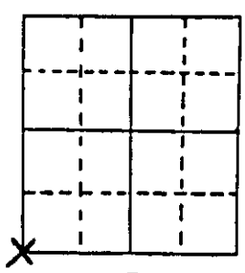

Section 7

(b) (f) (g) (h) Description of monument found at this corner and if it was accepted, state all evidence (material, testimonial, occupational, plats, records, other monuments) used as a basis for accepting. I not accepted or if nothing was found, state evidence used as basis for establishing location. I reestablished through lost corner proportionate methods, indicate all monuments, distances and directions used to establish.

September 8, 1860 by Alfred Millard at 80.00 chains set post for section corner:
6" Aspen, N62°E, 15 links (9.90').
9" Aspen, S23°E, 13 links (8.58').
8" Aspen, S41°W, 15 links (9.90').
9" Aspen, N34°W, 5 links (3.30').
September 16, 1936; Maine restored corner and set Oneida County monument and made two BTs:
6" Oak, N42°E, 78 links (51.48').
6" Oak, N15°W, 108 links (71.28').
Demceber 4, 1987; Milo E. Stefan found 2" x 36" galv. iron pipe with brass cap in mound of stone with Maine's BTs in good condition.

(c) (d) (e) Plan view of corner with ties to at least 4 witness monuments. If in disagreement with previously established corner, show the distances between the two corners and also indicate the ties to the disputed corner.

1. 2" x 36" Oneida County Monument.
2. 12" Red Oak, N42°E, 51.17'.
3. 20" White Pine, S51°E, 121.88'.*
4. 10" Red Maple, S21°W, 15.04'.*
5. 16" Red Oak, N9°W, 71.06'.
6. Plastic sign post, SW, 1.3'

* BTs scribed "T37N R8E S(section)BT"
Distances measured to nail in side of trees.

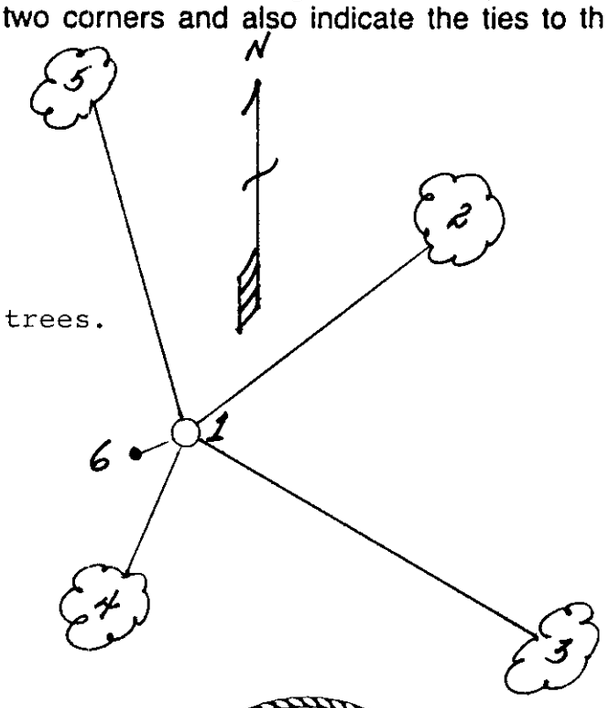

(i) I, Milo E. Stefan (type or print name) certify that the corner location on this record was determined by me or under my direction and control and that this U.S. Public Land Survey Monument Record is correct and complete to the best of my knowledge and belief.

Milo E. Stefan — Signature

12/6/87 — Date

WISCONSIN MILO E. STEFAN S-1558 RHINELANDER, WIS. LAND SURVEYOR

Index No. J-1

370712 0000