

CERTIFIED LAND CORNER RESTORATION

State of Wisconsin }
County of Oneida } ss.



I, James D. Rein, do hereby certify that on the 26th day of March, 1979, I found evidence of the Northwest corner of Section 19 Township 37 North, Range 8 East, Fourth Principal Meridian, as described hereon; and that from this evidence I established a new monument and accessories as described hereon to perpetuate the original location of this corner:

Description of original monument and accessories and subsequent restorations:
wood post set by Alfred Millard on the 8th of September 1860, witnessed by the following B.T.s: 9" Aspen, S59°E, 16 lks (10.56 feet); 7" Aspen N25°E, 8 lks (5.28 feet); 7" Aspen N44°W, 25 lks (16.50 feet), 6" Aspen S59°W, 18 lks (11.83 feet).
V. W. Maine, June 11th, 1936 set official iron pipe, identified by old square stake and one original D.T. broken off and down 7" white pine N44°W, 25 lks (16.50 feet)
D. H. Vaughn 14" white pine stump S26 1/2°W .50 ch (33.00 feet) corner sets in logging road marked new B.T.s 8" white pine stump S47°W, .67 ch (44.22 feet) 10" white pine stub N84 1/2°E, 86 lks (56.76 feet)
brass capped monument found by F. R. Wincentzen, Oneida County Surveyor on the 15th of February, 1956, witness by a white pine stump S47°W, 67 lks (44.22 ft.)
Description of corner evidence found: 10" white pine N84°-30'E, 86 lks. (56.76 feet)

2" diameter brass capped iron pipe up 2 feet, the monument is located 16 feet southeast of the center of an old logging road.

Description of monument and accessories I established to perpetuate the location of this corner:
made bearing trees with P.K. nails set in the lower blaze to witness the location of the existing brass capped iron pipe as follows:

- 8" Norway Pine N45°E, 16.37 feet
11" White Pine S52°E, 12.12 feet
12" Norway Pine S30°W, 28.55 feet

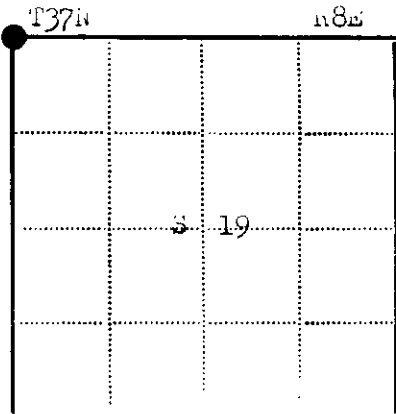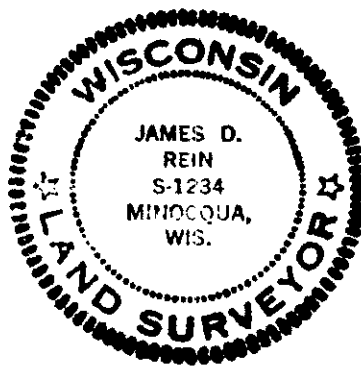

Legend:
● - Corner monument restored
□ -

Resident witnesses none

Dated at Minocqua Wisconsin, this 10th day of September, 1979.

Signature James D. Rein Title Reg. Land Surveyor
(County Surveyor, Registered Land Surveyor, or other duly authorized official)

Surveyors Registration No. S-1234

Office of REGISTER OF DEEDS County of Oneida

I hereby certify that the within instrument was filed in this office for record on the 17th day of September, 1982, and was filed in Book No. Page No. of County Records.

Signature Doris Verage Kuehn Title REGISTER OF DEEDS

Township, Range, Section, Index No., Page No.

3707130000