

CERTIFIED LAND CORNER RESTORATION

State of Wisconsin }
County of Oneida } ss.


I Dennis L. Stella, do hereby certify that on the 15th day of May, 1978, I found evidence of the NW MC Govt Lot 1 corner of Sec. 24 Township 37N, Range 7E, Fourth Principal Meridian, as described hereon; and that from this evidence I established a new monument and accessories as described hereon to perpetuate the original location of this corner:

Description of original monument and accessories and subsequent restorations:



Corner: Set wood post
Bearing Trees: Tamarack 6", S51°E, 32 Lks
Tamarack 6", N57°W, 13 Lks

Description of corner evidence found:

Found DNR wood post set in 1930.

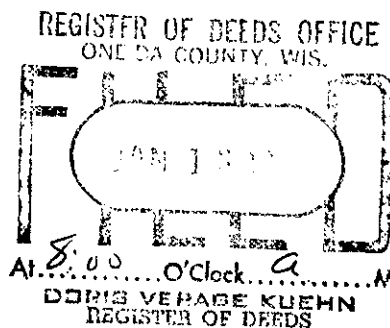

Description of monument and accessories I established to perpetuate the location of this corner:

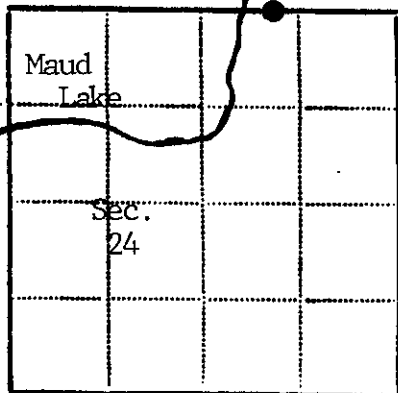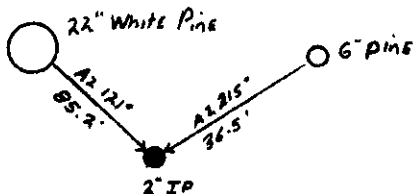

● - Corner monument restored
□ -

Resident witnesses.....

Dated at Rhineland Wisconsin, this 16 day of October 1979..

Signature Dennis L. Stella Title RLS 1352
(County Surveyor, Registered Land Surveyor, or other duly authorized official)

Surveyors Registration No. 1352

Office of..... County of.....

I hereby certify that the within instrument was filed in this office for record on the.....day of.....19....., and was filed in Book No.....Page No.....of County Records.

Signature..... Title.....

Township....., Range....., Section....., Index No....., Page No.....

3707130018

CERTIFIED LAND CORNER RESTORATION

State of Wisconsin }
County of Oneida } ss.

I David F. Mc Mullen, do hereby certify that on the 17 day of September 19 81 I found evidence of the meander corner E. of Maud L. corner of on the S. Line of Sec. 13 Township 37 North, Range 7 East, Fourth Principal Meridian, as described hereon; and that from this evidence I established a new monument and accessories as described hereon to perpetuate the original location of this corner:

Description of original monument and accessories and subsequent restorations:


Wood post set (November 1862 - Jos. H. Jenkins)
Bearing trees: 6" Tamarack; S51°E, 32lks
6" Tamarack; N57°W, 13lks
June 12, 1936 - V. M. Maine
New Oak stake set
Bearing tree: 12" Yellow Pine; N56°W, 1.29½ch

Description of corner evidence found:

1½" Iron pipe and Wood post w/metal tag
Bearing tree: 18" Norway Pine; N51°W, 85.0'

Description of monument and accessories I established to perpetuate the location of this corner:

Set Oneida County aluminum cast Berntsen monument
Made bearing trees: 5" White Pine; N20°W, 78.40'
5" Tamarack; N61°E, 37.40'
4" Tamarack; S71°E, 44.50'

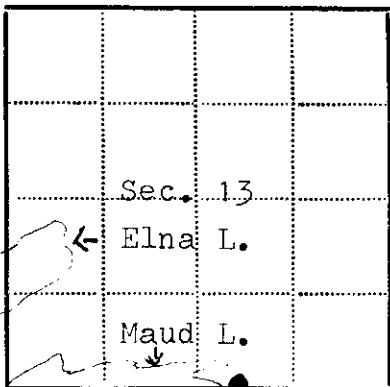

● - Corner monument restored
□ -

Resident witnesses.....


Signature David F. Mc Mullen Title Registered Land Surveyor
(County Surveyor, Registered Land Surveyor, or other duly authorized official)

Surveyors Registration No. S - 1340

Office of REGISTER OF DEEDS County of Oneida

I hereby certify that the within instrument was filed in this office for record on the 17th day of September 1982, and was filed in Book No. _____ Page No. _____ of County Records.

Signature Toria Verage Kuehn Title REGISTER OF DEEDS

Township 37 North, Range 7 East, Section 13, Index No. _____, Page No. _____

N. 23