

CERTIFIED LAND CORNER RESTORATION

State of Wisconsin }
County of Oneida } ss.

I David F. McMullen, do hereby certify that on the 16 day of September, 1981, I found evidence of the East One quarter corner of Section 13 Township 37 North, Range 7 East, Fourth Principal Meridian, as described hereon; and that from this evidence I established a new monument and accessories as described hereon to perpetuate the original location of this corner:

Description of original monument and accessories and subsequent restorations:



August 8 - 1860 (Alford Millerd)
Bearing Trees: 12" White Pine-no bearing or distance
6" Aspen-no bearing or distance
Official Brass Capped and Stamped Iron Pipe - set by V. M. Maine
September 16, 1936
Bearing Tree: 20" Yellow Pine Stump. S38°W, .71ch

Description of corner evidence found:

Brass Capped Iron pipe, stamped by V. M. Maine in 1936
No Bearing Trees Visible

Description of monument and accessories I established to perpetuate the location of this corner:

Made following Bearing Trees:
6" Maple; S36°E, 4.80'
5" White Birch; N48°E, 11.20'
7" Oak; N57°W, 11.35'
6" Maple; S82°W, 32.65'

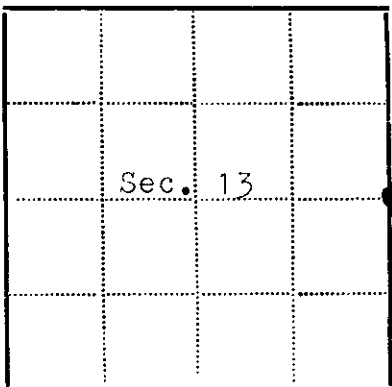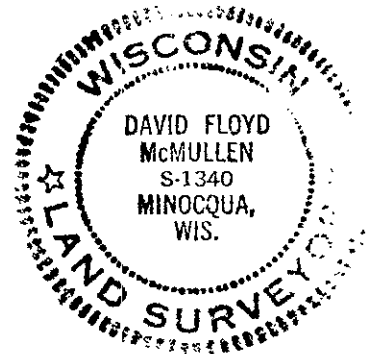

● - Corner monument restored
□ -

Resident witnesses.....

Dated at Minocqua Wisconsin, this 11 day of Jan 1982

Signature David F. McMullen Title Registered Land Surveyor
(County Surveyor, Registered Land Surveyor, or other duly authorized official)

Surveyors Registration No. S-1340

Office of REGISTER OF DEEDS County of Oneida

I hereby certify that the within instrument was filed in this office for record on the 17th day of September 1982, and was filed in Book No. Page No. of County Records.

Signature Doris Verage Kuehn Title REGISTER OF DEEDS

Township 37 North, Range 7 East, Section 13, Index No., Page No.

3707132000

7-25