

CERTIFIED LAND CORNER RESTORATION

State of Wisconsin }  
County of Oneida } ss.

I David F. Mc Mullen, do hereby certify that on the 16 day of September, 1981, I found evidence of the meander corner S. of Elna L. corner of on the W. Line of Sec. 13 Township 37 North, Range 7 East, Fourth Principal Meridian, as described hereon; and that from this evidence I established a new monument and accessories as described hereon to perpetuate the original location of this corner:

Description of original monument and accessories and subsequent restorations:



Not in course of original survey  
V. M. Maine - June 29, 1936  
Set Oak stake  
Bearing trees: Y. Pine 11"; N13°E, .59ch

Description of corner evidence found:

Not evidence found  
Set corner on section line

Description of monument and accessories I established to perpetuate the location of this corner:

Set Oneida County Berntsen cast aluminum monument  
Bearing trees: 9" White Birch; N38°E, 10.00'  
6" White Birch; N88°E, 18.24'  
10" Oak; S57°E, 5.45'  
7" White Birch; S77°W, 9.41'

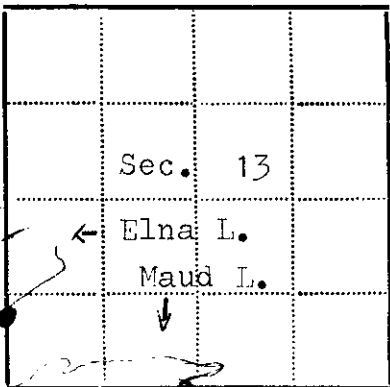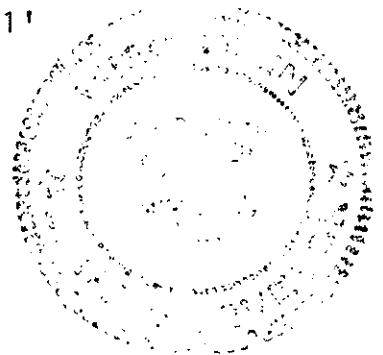

● - Corner monument restored  
□ -

Resident witnesses.....

Dated at Wausau Wisconsin, this 11 day of Jan 1982

Signature David F. Mc Mullen Title Registered Land Surveyor  
(County Surveyor, Registered Land Surveyor, or other duly authorized official)

Surveyors Registration No. S - 1340

Office of REGISTER OF DEEDS County of Oneida

I hereby certify that the within instrument was filed in this office for record on the 17th day of September 1982, and was filed in Book No. \_\_\_\_\_ Page No. \_\_\_\_\_ of County Records.

Signature Loris Terage Kuehn Title REGISTER OF DEEDS

Township 37 North, Range 7 East, Section 13, Index No. \_\_\_\_\_, Page No. \_\_\_\_\_

M. 21

3707140700