

CERTIFIED LAND CORNER RESTORATION

State of Wisconsin }
County of Oneida } ss.

I, David F. McMullen, do hereby certify that on the 16 day of September, 1981, I found evidence of the meander corner on the W. Line corner of of Sec. 13, N. of Elna L. Township 37 North, Range 7 East, Fourth Principal Meridian, as described hereon; and that from this evidence I established a new monument and accessories as described hereon to perpetuate the original location of this corner:

Description of original monument and accessories and subsequent restorations:


Not set in course of original survey
V. M. Maine - June 29, 1936
Oak Stake set
Bearing tree: 8" Oak S80W, .92ch

Description of corner evidence found:

Old Pine stump scribed "MC" bearing N49°E, 12.3' from pile of rock on Section Line.

Description of monument and accessories I established to perpetuate the location of this corner:

Set Oneida County Berntsen cast aluminum monument
Made bearing trees: 6" White Pine; S49°W, 16.95'
10" White Pine; S60°E, 24.11'

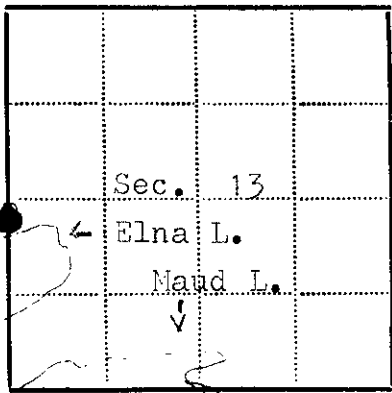

● - Corner monument restored
□ -

Resident witnesses _____

Dated at Minocqua Wisconsin, this 11 day of Jan 1982

Signature David F. McMullen Title Registered Land Surveyor
(County Surveyor, Registered Land Surveyor, or other duly authorized official)

Surveyors Registration No. S-1340

Office of REGISTER OF DEEDS County of Oneida

I hereby certify that the within instrument was filed in this office for record on the 17th day of September 1982, and was filed in Book No. _____ Page No. _____ of County Records.

Signature Lois Verage Kuehn Title REGISTER OF DEEDS

Township 37 North, Range 7 East, Section 13, Index No. _____, Page No. _____

3707141600

L-21