


U.S. PUBLIC LAND SURVEY MONUMENT RECORD

Note: This form is intended and designed to fulfill all requirements of Wisconsin Administrative Code, Chapter A-E 5.02, U.S. Public Land Survey Monument Record (3) (a) (b) (c) (d) (e) (f) (g) (h) (i). An additional sheet may be added if necessary to conform with said requirements.

(a) Corner location: Township 37 North
Range 7 East/~~West~~
Town/City/Village Cassian
County Oneida

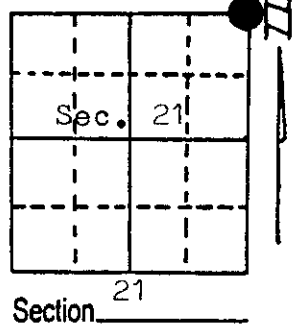

(b) (f) (g) (h) Description of monument found at this corner and if it was accepted, state all evidence (material, testimonial, occupational, plats, records, other monuments) used as a basis for accepting. If not accepted or if nothing was found, state evidence used as basis for establishing location. If reestablished through lost corner proportionate methods, indicate all monuments, distances and directions used to establish. Original survey Joseph H. Jenkins in 1862.
W.Pine 12, S20W, 40 lks., Tam 12, S29E, 6 lks., Tam 8, N61E, 15 lks.
Tam 8, N20W, 28 lks. North 5 ch. enter swamp, West 2.5 ch. enter swamp.



V.M. Main (See Main's book page 114) on Oct. 8, 1936 monumented corner. He used Ira Smiyh's identification and a old square stake as evidence. Marked new B.T.'s. W.Pine stub 12, S3W, 36 lks. W.Pine stp. 10, N65W, 50½ lks. W.Pine stp. 10, S01W, 70½ lks.

June 12, 1987; I found county monument. Main's records show Oct. 1936 but monument is stamped 1937.

I blazed and scribed the following new bearing trees and set 6 penny galvanized nails in the sides of the trees as indicated in the sketch.

1. Maple 9", N5E, 26.20 ft.
 2. white Birch 11", S65E, 9.07 ft.
 3. white Birch 6", S11, 19.19 ft.
 4. Aspin 7", N14W, 30.17
- Set Witness post 6" NW of Monument.

(c) (d) (e) Plan view of corner with ties to at least 4 witness monuments. If in disagreement with previously established corner, show the distances between the two corners and also indicate the ties to the disputed corner.

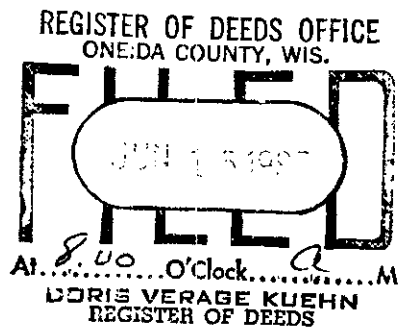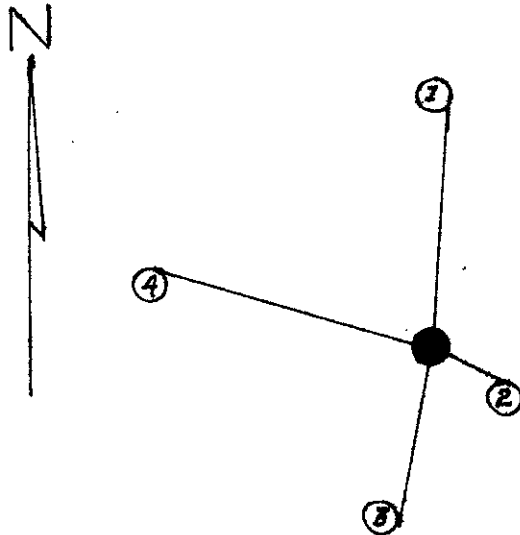

(i) I, Jean F. Resvick, RLS - 3-302
(type or print name) certify that the corner location on this record was determined by me or under my direction and control and that this U.S. Public Land Survey Monument Record is correct and complete to the best of my knowledge and belief.

Jean F. Resvick 6-17-87
Signature Date



3707160000

Index No. N-13