


U.S. PUBLIC LAND SURVEY MONUMENT RECORD

Note: This form is intended and designed to fulfill all requirements of Wisconsin Administrative Code, Chapter A-E 5.02, U.S. Public Land Survey Monument Record (3) (a) (b) (c) (d) (e) (f) (g) (h) (i). An additional sheet may be added if necessary conform with said requirements.

(a) Corner location: Township 37 North
 Range 7 East/West

Town/City/Village Cassian
 County Oneida

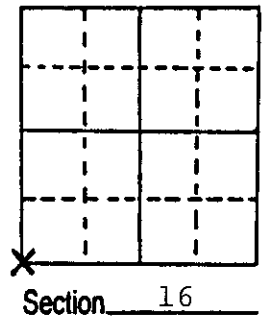


(b) (f) (g) (h) Description of monument found at this corner and if it was accepted, state all evidence (material, testimonial, occupational, plats, records, other monuments) used as a basis for accepting. not accepted or if nothing was found, state evidence used as basis for establishing location. reestablished through lost corner proportionate methods, indicate all monuments, distances and directions used to establish.

November 1862, Joseph H. Jenkins set post for section corner 16, 17, 20, 21:
 10" W. Pine, N47°E, 38 links (25.08')
 10" Birch, S46°E, 35 links (23.10')
 8" Y. Pine, S46°W, 42 links (27.72')
 8" Birch, N43°W, 37 links (24.42')
 March 1968, Wincentzen found iron pipe with 10" W. Pine snag, N47°E, 38 links.
 May 24, 1988 Milo E. Stefan found iron pipe, 1" x 24" with 12" Aspen snag S20°W - face overgrown.
 10" Sugar Maple N19°E, 65.70 feet - face overgrown, not opened up.
 I accept this iron pipe as the perpetuated position of the original corner position and placed county monument and made new BTs.

(c) (d) (e) Plan view of corner with ties to at least 4 witness monuments. If in disagreement with previously established corner, show the distances between the two corners and also indicate the ties to the disputed corner.

1. 2" x 36" Oneida County aluminum monument.
2. 10" Sugar Maple, N19°E, 65.70 feet.
3. 6" Red Oak, N86°E, 40.69 feet (T37N R7E S16 BT)
4. 4" Red Oak, S39°W, 20.26 feet (X BT)
5. 8" Red Maple, N52°W, 25.79 feet (T37N R7E S17 BT)
6. Plastic sign post, south, 1.0 feet

(trees scribed accordingly)
 Distances to nail in side of trees.

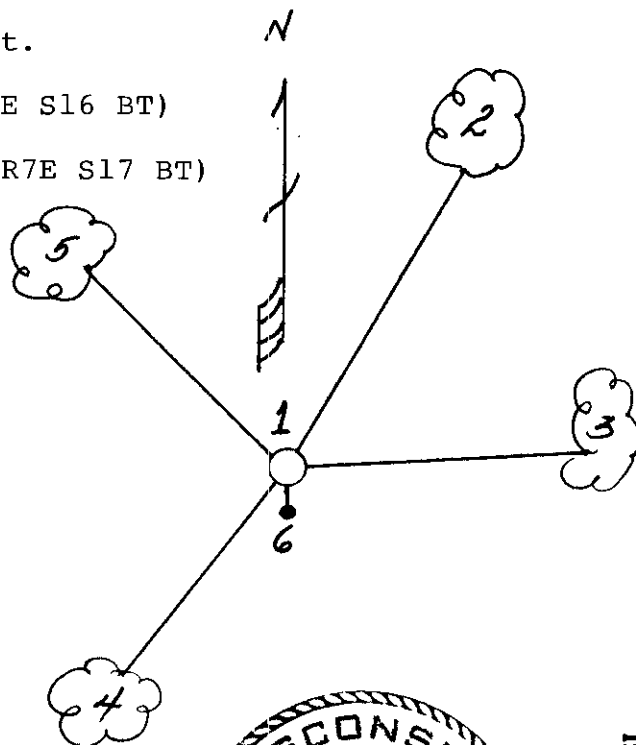

(i) I, Milo E. Stefan
 (type or print name) certify that the corner location on this record was determined by me or under my direction and control and that this U.S. Public Land Survey Monument Record is correct and complete to the best of my knowledge and belief.

Milo E. Stefan
 Signature

May 24, 1988
 Date



Index No. N-9

3707170000