


U.S. PUBLIC LAND SURVEY MONUMENT RECORD

Note: This form is intended and designed to fulfill all requirements of Wisconsin Administrative Code, Chapter A-E 7.08 U.S. Public Land Survey Monument Record (3) (a) (b) (c) (d) (e) (f) (g) (h) (i). An additional sheet may be added if necessary to conform with said requirements.

(a) Corner location: Township 37 North
 Range 7 East/West

Town/City/Village CASSIAN
 County ONEIDA

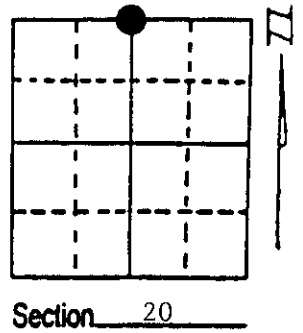

(b) (f) (g) (h) Description of monument found at this corner and if it was accepted, state all evidence (material, testimonial, occupational, plats, records, other monuments) used as a basis for accepting. If not accepted or if nothing was found, state evidence used as basis for establishing location. If reestablished through lost corner proportionate methods, indicate all monuments, distances and directions used to establish. Indicate type of monument found or set and sign post.


1862 - Joseph Jenkins established this corner and set a wood post with two BTs:
 8" White Pine, S4°E, 21 Links 6" Birch, N20°W, 10 Links

4/22/1994 - Milo E. Stefan found 3" x 36" iron pipe marking corner with 2" x 36" reference monument, N40°E, 6.95'. We removed the reference monument (so as to remove the confusion of two monuments) and re-set it in position of the steel pipe. Took new BTs and placed plastic sign post as indicated below.

(c) (d) (e) Plan view of corner with ties to at least 4 witness monuments. If in disagreement with previously established corner, show the distances between the two corners and also indicate the ties to the disputed corner.

- 1) 2" x 30" aluminum monument.
- 2) 3" Balsam Fir, N67°E, 11.62'.
- 3) 12" Red Oak, S49°E, 29.77'.
- 4) 5" Red Maple, N81°W, 12.52'.
- 5) 10" Aspen, N18°W, 1.88'.
- 6) Plastic sign post, NE, 1.0'.

Distances to nail in side of BTs.
 Stump blaze scribed "BT".

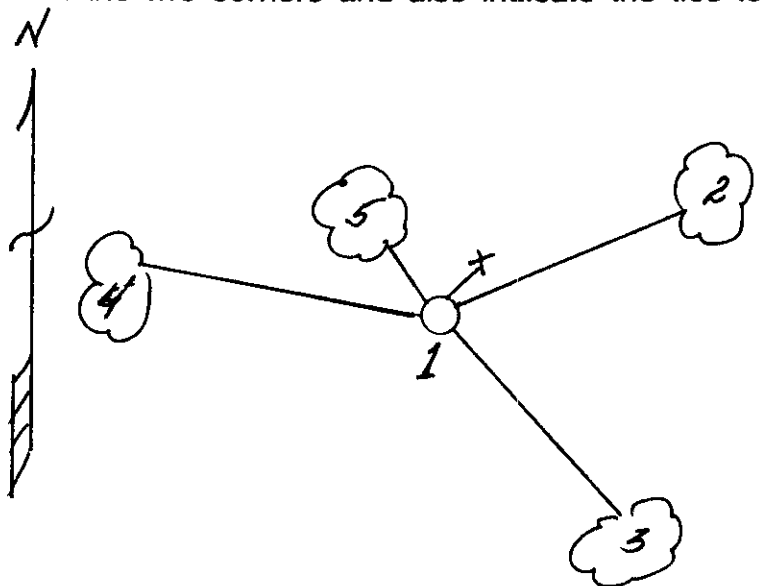

(i) I, Milo E. Stefan
 (type or print name) certify that the corner location on this record was determined by me or under my direction and control and that this U.S. Public Land Survey Monument Record is correct and complete to the best of my knowledge and belief.

Milo E. Stefan

May 19, 1994

Signature

Date



Index No. N-7

3707170020
 Stamp