


U.S. PUBLIC LAND SURVEY MONUMENT RECORD

Note: This form is intended and designed to fulfill all requirements of Wisconsin Administrative Code, Chapter A-E 7.08 U.S. Public Land Survey Monument Record (3) (a) (b) (c) (d) (e) (f) (g) (h) (i). An additional sheet may be added if necessary to conform with said requirements.

(a) Corner location: Township 37 North
 Range 7 East/West

Town/City/Village Cassian

County Oneida

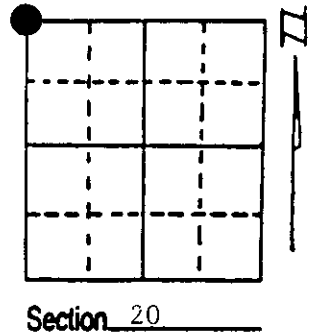

(b) (f) (g) (h) Description of monument found at this corner and if it was accepted, state all evidence (material, testimonial, occupational, plats, records, other monuments) used as a basis for accepting. If not accepted or if nothing was found, state evidence used as basis for establishing location. If reestablished through lost corner proportionate methods, indicate all monuments, distances and directions used to establish. Indicate type of monument found or set and sign post.

11/1862 - Joseph Jenkins established this corner at 80.00 chains and set Section Corner post with BTs:
 8" Tamarack, N30°E, 4 Links (2.64')
 6" Spruce, S40°E, 19 Links (12.54')
 6" Spruce, S30°W, 11 Links (7.26')
 8" Spruce, N61°W, 27 Links (17.82')


11/16/1993 - With aid of Tom Herman, Milo E. Stefan found 3" x 3" x 5' scribed Cedar Post and 2" iron pipe with 16" White Pine BT S27°E, 24.75' by Griffin 40 - 50 years ago. Two more BTs by unknown parties: 18" White Pine, S42°W, 8.06'; 5" Tamarack, N17°E, 16.36'. Tom Herman's grand-dad pointed this corner out to him fifty years ago and was here in the early 1900's when he first saw it.

We replaced iron pipe with an Oneida County monument and made new BTs and set plastic sign post.

(c) (d) (e) Plan view of corner with ties to at least 4 witness monuments. If in disagreement with previously established corner, show the distances between the two corners and also indicate the ties to the disputed corner.

- 1) 2" x 60" Aluminum Monument.
- 2) 7" Tamarack, N32°E, 43.51'.
- 3) 6" Tamarack, S67°E, 24.11'.
- 4) 16" White Pine, S27°E, 24.75'.
- 5) 6" Tamarack, S84°W, 36.25'.
- 6) 5" Tamarack, N17°E, 16.36'.
- 7) 18" White Pine, S42°W, 8.06'.
- 8) Plastic sign post, South, 1.5'.

Distances to nail in side of BTs.
 Stump blazes scribed "BT".

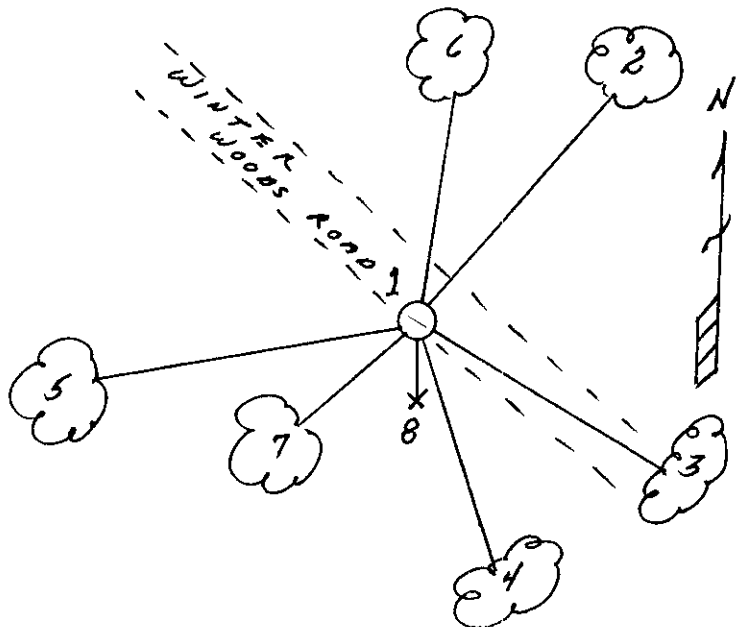

(i) I, Milo E. Stefan
 (type or print name) certify that the corner location on this record was determined by me or under my direction and control and that this U.S. Public Land Survey Monument Record is correct and complete to the best of my knowledge and belief.

Milo E. Stefan
 Signature

February 2, 1994
 Date



Index No. N-5

Stamp 3707 180000