


U.S. PUBLIC LAND SURVEY MONUMENT RECORD

Note: This form is intended and designed to fulfill all requirements of Wisconsin Administrative Code, Chapter A-E 7.08 U.S. Public Land Survey Monument Record (3) (a) (b) (c) (d) (e) (f) (g) (h) (i). An additional sheet may be added if necessary to conform with said requirements.

(a) Corner location: Township 37 North
 Range 7 East/West
 Town/City/Village Cassian
 County Oneida

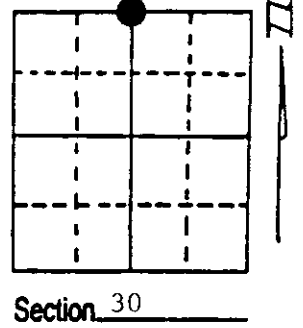

(b) (f) (g) (h) Description of monument found at this corner and if it was accepted, state all evidence (material, testimonial, occupational, plats, records, other monuments) used as a basis for accepting. If not accepted or if nothing was found, state evidence used as basis for establishing location. If reestablished through lost corner proportionate methods, indicate all monuments, distances and directions used to establish. Indicate type of monument found or set and sign post.


11/1862 - Joseph Jenkins established this corner at 41.82 chains East of Range Line, set 1/4 post and made two BTs:
 8" Red Pine, N85°E, 190 Links (125.40')
 7" White Pine, S84°E, 192 Links (126.72')

10/22/1993 - Milo E. Stefan found 6" x 6" x 48" scribed cedar post 120' West of high ground in Black Spruce - Tamarack Swamp. Distance to Section Corner Easterly is 2807.56 feet. Note long calls to original BTs and close to line indicates that this corner was originally placed in this swamp. The call to the Red Pine Stump fits good for distance, but is S84°E. (Did the note keeper just reverse the tree species? I suggest he did.) I, therefore, accept this post as the perpetuated position of the original 1/4 Corner and restore same. We placed a 2" x 60" aluminum Oneida County monument and made four new BTs and set a plastic sign post.

(c) (d) (e) Plan view of corner with ties to at least 4 witness monuments. If in disagreement with previously established corner, show the distances between the two corners and also indicate the ties to the disputed corner.

- 1) 2" x 60" Aluminum Monument.
- 2) 4" Tamarack, N35°E, 18.11'.
- 3) 5" Tamarack, S20°E, 28.76'.
- 4) 3" Tamarack, S64°W, 10.74'.
- 5) 3" Black Spruce, N32°W, 26.24'.
- 6) 12" - 14" Red Pine Stump, S84°E, 126.72'.
- 7) Plastic sign post, East, 1.0'.

Distances to nail in side of BTs.
 Stump blazes scribed "BT".

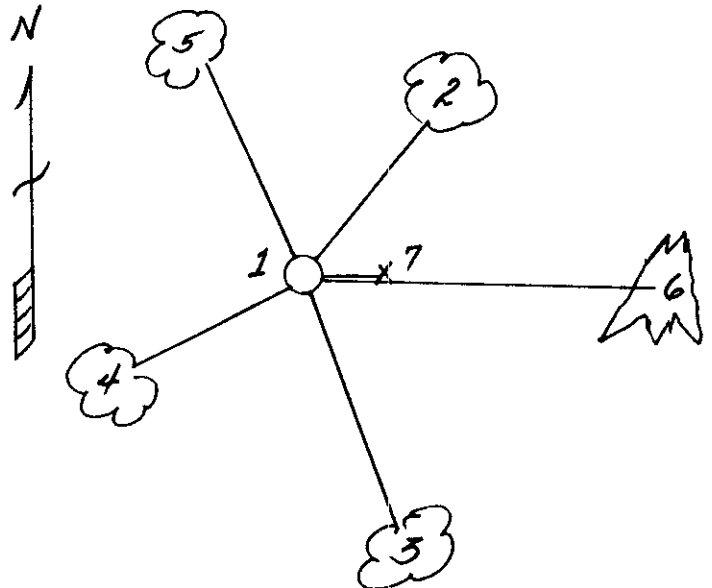

(i) I, Milo E. Stefan
 (type or print name) certify that the corner location on this record was determined by me or under my direction and control and that this U.S. Public Land Survey Monument Record is correct and complete to the best of my knowledge and belief.

Milo E. Stefan January 2, 1994
 Signature Date



Index No. R-3

3707190020
Stamp