U.S. PUBLIC LAND SURVEY MONUMENT RECORD

Note: This form is intended and designed to fulfill all requirements of Wisconsin Administrative Code, Chapter A-E 7.08 U.S. Public Land Survey Monument Record (3) (a) (b) (c) (d) (e) (f) (g) (h) (i). An additional sheet may be added if necessary to conform with said requirements.

(a) Corner location: Township 37 North

Range 7 East/~~West~~

Town/~~City~~/~~Village~~ Cassian

County Oneida

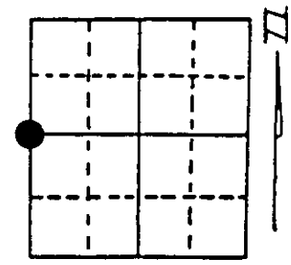

Section 20

(b) (f) (g) (h) Description of monument found at this corner and if it was accepted, state all evidence (material, testimonial, occupational, plats, records, other monuments) used as a basis for accepting. If not accepted or if nothing was found, state evidence used as basis for establishing location. If reestablished through lost corner proportionate methods, indicate all monuments, distances and directions used to establish. Indicate type of monument found or set and sign post.

11/1862 - Joseph Jenkins established this corner at 40.00 chains and set 1/4 Section Post with two BTs:
8" Y. Pine, S58°E, 31 Links (20.46')
8" Birch, N67°W, 10 Links (6.60')

4/1958 - Nekoosa-Edwards Co. used this fence corner for 1/4 Corner.

10/28/1993 - Milo E. Stefan found fence corner and accepted it as the best available evidence of the original corner position.
We set an Oneida County monument and made four new BTs and placed a plastic sign post.

(c) (d) (e) Plan view of corner with ties to at least 4 witness monuments. If in disagreement with previously established corner, show the distances between the two corners and also indicate the ties to the disputed corner.

1) 2" x 30" Aluminum Monument.
2) 8" Red Maple, N15°E, 49.25'.
3) 6" Red Maple, N90°E, 45.40'.
4) 8" Red Maple, S40°E, 54.16'.
5) 10" Red Maple, S22°E, 39.63'.
6) Plastic sign post, North, 1.0'.

Distances to nail in side of BTs.
Stump blazes scribed "BT".

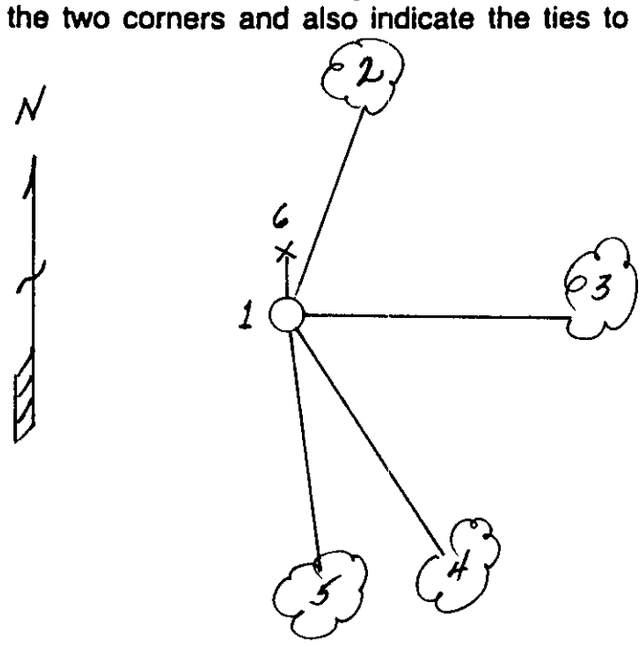

(i) I, Milo E. Stefan (type or print name) certify that the corner location on this record was determined by me or under my direction and control and that this U.S. Public Land Survey Monument Record is correct and complete to the best of my knowledge and belief.

Milo E. Stefan — February 2, 1994

Signature — Date

WISCONSIN MILO E. STEFAN S-1598 MINOCQUA, WIS. LAND SURVEYOR

Index No. P-5

Stamp 3707192000