

U.S. PUBLIC LAND SURVEY MONUMENT RECORD


Note: This form is intended and designed to fulfill all requirements of Wisconsin Administrative Code, Chapter A-E 7.08 U.S. Public Land Survey Monument Record (3) (a) (b) (c) (d) (e) (f) (g) (h) (i). An additional sheet may be added if necessary to conform with said requirements.

(a) Corner location: Township 37 North

Range 7 East/West

Town/City/Village CASSIAN

County ONEIDA

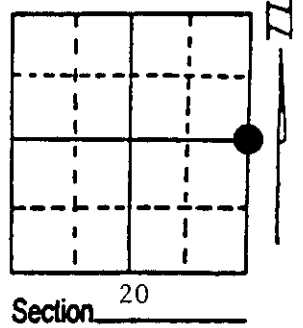

(b) (f) (g) (h) Description of monument found at this corner and if it was accepted, state all evidence (material, testimonial, occupational, plats, records, other monuments) used as a basis for accepting. If not accepted or if nothing was found, state evidence used as basis for establishing location. If reestablished through lost corner proportionate methods, indicate all monuments, distances and directions used to establish. Indicate type of monument found or set and sign post.

1862 - Joseph H. Jenkins established this corner at 40.00 chains and set a wood post with two BTs:


8" White Pine, N68°W, 17 Links 6" Sugar, S73°E, 27 Links

4/22/1994 - Milo E. Stefan found no trace of a corner as a result of road construction. As a road intersection in four directions is here, we used the center lines of Webster Road and Grace Lane and placed a railroad spike for the corner. We then placed two reference monuments, with bearing trees and plastic sign post as indicated below.

(c) (d) (e) Plan view of corner with ties to at least 4 witness monuments. If in disagreement with previously established corner, show the distances between the two corners and also indicate the ties to the disputed corner.

- 1) Railroad spike.
- 2) 3/4" x 30" re-bar, N42°E, 27.77'.
- 3) 2" x 30" aluminum monument, N42°E, 56.30'.
- 4) 12" Red Oak, N59°E, 157.80'.
- 5) 8" Tamarack, S33°W, 87.78'.
- 6) 6" Red Pine, N40°W, 42.20'.
- 7) Plastic sign post next to aluminum monument.

Distances to nail in side of BTs.
Stump blazes scribed "BT".

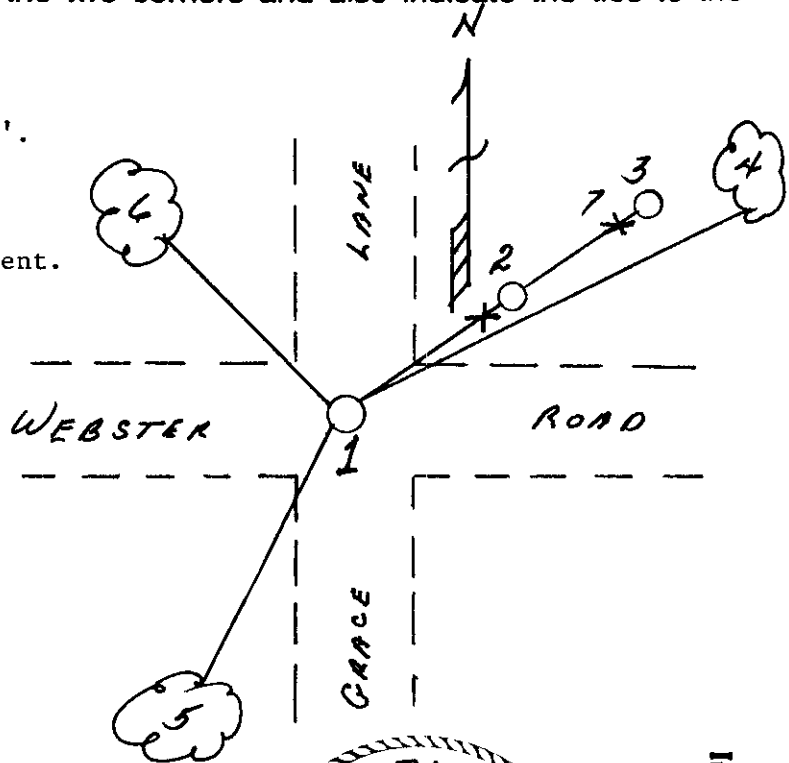

(i) I, Milo E. Stefan
(type or print name) certify that the corner location on this record was determined by me or under my direction and control and that this U.S. Public Land Survey Monument Record is correct and complete to the best of my knowledge and belief.

Milo E. Stefan 5/19/94
Signature Date



Index No. P-9

Stamp 3707202000