


U.S. PUBLIC LAND SURVEY MONUMENT RECORD

Note: This form is intended and designed to fulfill all requirements of Wisconsin Administrative Code, Chapter A-E 5.02, U.S. Public Land Survey Monument Record (3) (a) (b) (c) (d) (e) (f) (g) (h) (i). An additional sheet may be added if necessary to conform with said requirements.

(a) Corner location: Township 37 North
 Range 7 East/West

Town/City/Village Cassian


County Oneida

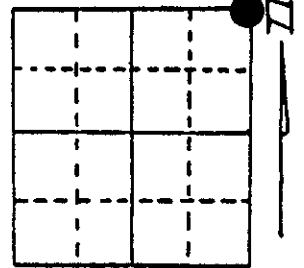

Section 28

(b) (f) (g) (h) Description of monument found at this corner and if it was accepted, state all evidence (material, testimonial, occupational, plats, records, other monuments) used as a basis for accepting. If not accepted or if nothing was found, state evidence used as basis for establishing location. If reestablished through lost corner proportionate methods, indicate all monuments, distances and directions used to establish.

Found 2" iron pipe with 2" diameter
 Brass Tablet stamped to identify corner.

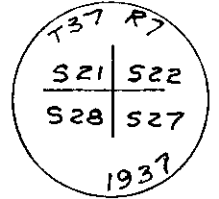


This corner was set in 1937 by V. M. Maine, he perpetuated a corner by Wm. Allen's and D. H. Vaughan, identified by Old Squared Stake and D. H. Vaughan's B.T.'s.

| | | | |
|------------------------------------|-----|-----------|------------|
| White Pine Stp. | 10" | N34-1/2°W | .18 |
| White Pine Stp. | 15" | S88°E | .25 |
| V. M. Maine set New BT | | | |
| Oak | 16" | S22°W | .48 |
| I found V. M. Maine BT, now an Oak | 16" | S22°W | 31.68 feet |


also blazed line north and south painted blue.

(c) (d) (e) Plan view of corner with ties to at least 4 witness monuments. If in disagreement with previously established corner, show the distances between the two corners and also indicate the ties to the disputed corner.

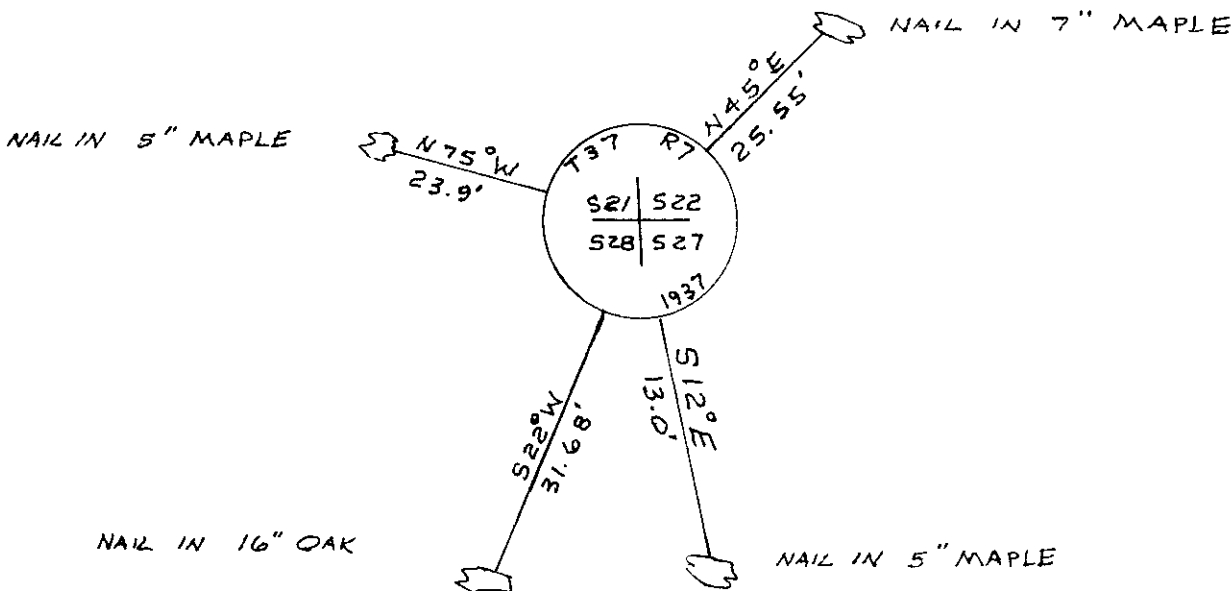

(i) I, ~~Dennis B. Roberts~~ Dennis B. Roberts
 (type or print name) certify that the corner location on this record was determined by me or under my direction and control and that this U.S. Public Land Survey Monument Record is correct and complete to the best of my knowledge and belief.

Dennis B. Roberts March 27, 1986
 Signature Date

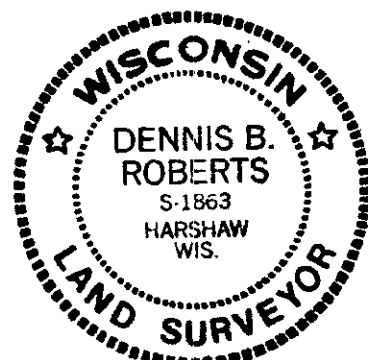

Index No. R-13

3707210000